

October 21, 2021

Adams County Attn: Greg Barnes 4430 S. Adams County Parkway Brighton, CO 80601

Re: Berkeley Villas (Formally known as: TTLC Denver – Federal) – 2<sup>nd</sup> Review Comments Project Number: PRC2021-00002

Dear Mr. Barnes:

Thank you for taking the time to review the Berkeley Villas (Formally known as: TTLC Denver – Federal) TOD along with County staff. Valuable feedback was received on September 28, 2021. Detailed responses to comments made can be found on the following pages. Please feel free to reach out should you have any questions or concerns by phone, 303-892-1166 or by email, emather@norris-design.com.

We look forward to working with Adams County to make this project a success.

Thank you,

ma heate

Eva Mather Principal

# Development Review Team Comments Commenting Division: Planner Review Name of Reviewer: Greg Barnes PRELIMINARY PLAT COMMENTS PLN01: Please provide all street names. Typically, even private street names are included. Response: Streets have been labeled.

PLN02: Please refer to all lots being created as "lots" and not "parcels". Lot numbering should begin at 1 and numbering should not skip around. Lots should be numbered 1-78. *Response: Lots have been labeled as lots and numbered from 1-82.* 

PLN03: There is so much blank space on each page. I think pages 2 and 3 could be combined onto one page, even if drawn at the current scale.

Response: We are unable to change the scale without cutting off part of the property. Sheet count remains the same.

PLN04: The lot located west of Tracts A & C does not include property owner info. It also does not recently approved plat corrections which changed the boundaries (PLT2021-00001). *Response: Updated to show recent plat connections and property information.* 

PLN05: There is no clear boundary between Tracts B & G in the vicinity of "Parcel 132". *Response: Boundary has been clearly labeled.* 

PLN06: The far eastern boundary of Tract H is missing from Page 4. *Response: Southern part of eastern Tract H is shown on page 6 and the northern part is shown on page 5.* 

PLN07: Has the applicant acquired the Smith, Lechuga, Randall, and Graber properties? I do not believe that you can vacate someone's ownerships through a subdivision plat.

Response: It is our interpretation of the Adams County Code that only the person having interest in the property to be subdivided needs to sign. It is our intention to purchase the properties prior to final plat. A cover page and signature page of the contracts is included to show proof that we are under contract.

# **REZONING COMMENTS**

PLN08: The conceptual elevations still do not have distinctly different facades for each unit.

Response: Per recent correspondence with Jen Rutter seeking clarification on this comment, the current elevation designs were deemed appropriate. She said, "I spoke with a few staff members, and we think we understand Greg's intent, but we feel that the buildings are appropriate." As mentioned in our previous submittal responses the proposed elevation designs utilize differentiated unit plans, deck locations, massing, window placement and size, materials (lap siding or board and batten), porches, cantilevered decks, bay windows, and accent gable end roof forms to punctuate and define the facades of each single-family attached townhome.

Commenting Division: Development Engineering Review

# Name of Reviewer: Greg Labrie

The engineering plans and reports that were submitted for this preliminary plat application are acceptable at this time. The following comments will apply to the final engineering reports and construction plans that are required at



### final plat. Response: Comment noted, thank you.

ENG1: The final plans shall show that all concrete within the public right-of-way will be placed monolithically. *Response: Comment noted, thank you.* 

ENG2: The applicant shall show the location and design plans for the internal private roads and pedestrian sidewalks within the subdivision development.

Response: Comment noted, thank you.

ENG3: Concrete details will need to be added to the final construction plans. *Response: Comment noted, thank you.* 

ENG4: No construction can take place prior to the approval of a Subdivision Improvement Agreement (SIA). This agreement, along with the appropriate collateral must be approved by the Adams County Board of County Commissioners (BoCC).

### Response: Comment noted, thank you.

ENG5: Drainage Plans- Fill source and quantity including source and quantity of selected borrow pits and pertinent information showing where each type of fill is to be placed. Additional permitting is required for the hauling and installation of offsite fill material on the project site.

Response: Comment noted, thank you.

ENG6: Drainage Plans shall show the storm drainage structure profiles to include pipe sizes, pipe types and materials, lengths of runs, gradients and exact locations of pipes or channels, structure identifier (e.g. catch basin/manhole number) and the exact location of structure. Cross sections of roadways, channels, and basins shall be at 50 foot intervals. The cross section for detention basins shall include slope, depth, and erosion protection techniques.

# Response: Comment noted, thank you.

ENG7: Details shall be provided for all proposed drainage structures for which there is insufficient information in the plan or profile views (i.e. outlet configurations, headwall/wingwall, etc.). *Response: Comment noted, thank you.* 

ENG8: The applicant shall complete and submit an Operation & Maintenance Manual for all of the new drainage facilities installed on the site. The applicant's stormwater drainage report, drainage plans, and O&M Manual shall incorporate the applicable items as described in the checklists that can be found on the Adams County website, within the Development Standards and Regulations webpage, and in Appendix B which includes the engineering checklists and standard details.

# Response: Comment noted, thank you.

ENG9: Drainage easements are required on private property to accommodate the proposed storm pipe. This includes obtaining a drainage easement on adjacent properties where the storm pipe may be located such as the Maverik site.

Response: Comment noted, thank you.



ENG10: The site plan shall show the dimensions of the roadway system within the proposed development. Adams county local streets are 50' in width to include curb, gutter, and sidewalk. The applicant shall consider connecting at least one of the proposed internal streets with the Maverik development to the west and/or with 55th Avenue to the south.

#### Response: Comment noted, thank you.

ENG11: The final design plans shall designate areas for trash dumpsters and snow pile storage and identify the location of these areas on the plans.

#### Response: Comment noted, thank you.

Commenting Division: ROW Review Name of Reviewer: Davit Dittmer ROW1: The title should read: BERKELEY VILLAS SUBDIVISION PLAT A RESUBDIVISION OF (LOTS) OF THE WESTMOORLAND SUBDIVISION (FULL NAME OF CORRECT SUBDIVISION PLAT) BEING IN THE NE/4 OF ...... PRELIMINARY PLAT (Legal description should read Sec-T-R) *Response: Legal description has been revised.* 

ROW2: Correct typo in title *Response: Title has been corrected.* 

ROW3: Add case number to the top right-hand corner of each sheet (PRC2021-00003) *Response: Case number has been added.* 

ROW4: Need completed OWNERSHIP AND DEDICATION STATEMENT, including vesting deed information as being sole owner, full legal description, followed by the OWNER'S CERTIFICATE that needs to provide name and title of individual executing plat, and this information needs to be within Notary affirmation too.

a. This must include all parties to the subdivision which would include those parties as shown "To be vacated" because until this issue is dealt with they encroach and are a apart of the plat as provided. Response: It is our interpretation of the Adams County Code that only the person having interest in the property to be subdivided needs to sign. It is our intention to purchase the properties prior to final plat. A cover page and signature page of the contracts is included to show proof that we are under contract.

ROW5: Provide all notes as required by Colorado State Statutes and Adams County Design and Performance Standards including but not limited to the following:

- 1. Closure Statement
- 2. Basis of Bearings
- 3. Flood Plain Note
- 4. Drainage Facilities note with maintenance Manuel information
- 5. Full name of HOA as registered with the State for Tract Maintenance note *Response: Full name of the HOA will be provided prior to Final Plat.*



# ROW6: Remove Sheet index *Response: Sheet index has been removed.*

ROW7: Tract Table and Plat Keymap need to be revised as follows:

- 1. Tract Table should be shown full page Keymap with Tracts labeled as best as possible. *Response: Keymap sheet has been added.*
- 2. Sheet number 5 should be sheet number 2 followed by the site plan of the subdivision. *Response: Sheets have been rearranged per comment.*

ROW8: Rearrange APPROVALS:

Planning Commission Board of County Commissioners Clerk and Recorders And revise signature blocks as provided on plat redlines **Response: Approval blocks have been rearranged per comment.** 

ROW9: Add Title Block to pages (first one for sure) and remove the bottom right-hand corner plat name, sheet name, etc.

#### Response: Title Block has been added with the necessary information.

ROW10: Need to properly show the new lot lines as created by the RE-Subdivision of Westmoorland Plat Correction No. 2 recorded at Reception No: 2021000067065 (Lots 8A and 9A) *Response: New lot lines are now being shown.* 

ROW11: Sheet 5 to sheet 2 and the following corrections:

- Need to provide what lot lines are being vacated, as cannot build across lot lines.
   Response: General note stating that all internal lot lines are to be abandoned has been added.
- 2. Need to remove information as to "REMAIN" and only provide the ownership information as an adjacent owner.

Response: Language removed.

- 3. Need to properly depict adjacent ownership lot lines. *Response: Adjacent ownership lot lines are darkened for clarity.*
- 4. Need to correctly identify and show the lot lines for the E. 20' of Lot 4 and the S 20' of the E 85' of Lot 4 Resub of Westmoorland. THIS AREA HAS TO COME INTO THIS SUBDIVISION AND OWNERSHIP Response: This area is inside our lot line and has been shown with more clarity. The neighboring property to the east does not have legal claim to this area and has their own access strip.
- 5. Remove note concerning the Westmoorland subdivision recorded in Book 3, page 62. *Response: Note has been removed.*



- 6. Need to clean up the "To Be Vacated" as property ownership information as these parties need to be part of this case, or applicant needs ownership prior to submission of Preliminary Plat, as this cannot wait until the Final Plat is provided or an additional Plat Correction will be required. *Response: "To Be Vacated" language has been removed.*
- 7. Easements that are "To Be Vacated" need to have the additional language of "By Separate Document" as they cannot be vacated by this plat. These vacations will need to be complete by Final Plat with the vacation information by document and reception number provided. This will also be a part of the building permit application as no structures over these if not vacated. *Response: Language has been updated per comment.*
- 8. Appears there are lot line issues that don't make sense on Sheet 5. *Response: Plat keymap has been added and lot lines have been adjusted for clarity.*
- 9. Remove "Existing Conditions" on Sheet 5. *Response: Language removed per comment.*
- 10. Need to provide new lot name and sq. ft. and ac. Information once all lot lines are vacated by the plat. *Response: Comment noted, thank you.*

### ROW12: Review all redline comments provided on plat.

### Response: See redline comments for detailed responses to comments.

#### Comments Received by Pang Moua, Tri-County Health Department

Thank you for the opportunity to review and comment on the Site Plan and Plat for the 84 single-family attached townhome units on 4.9 acres located at 2922 West 56<sup>th</sup> Avenue. Tri-County Health Department (TCHD) staff previously reviewed the application for the Rezoning and Preliminary Plat for Major Subdivision and provided comments in a letter dated June 30, 2021. TCHD received a response from the applicant, dated August 24, 2021, and the applicant has responded to the following comments satisfactorily. No further information is required. *Response: Comment acknowledged, thank you.* 

#### Community design to support walking and bicycling

Because chronic diseases related to physical inactivity and obesity now rank among the country's greatest public health risks, TCHD encourages community designs that make it easy for people to include regular physical activity, such as walking and bicycling, in their daily routines. Because research shows that the way we design our communities can encourage regular physical activity, TCHD strongly supports community plans that incorporate pedestrian and bicycle amenities that support the use of a broader pedestrian and bicycle network. Increasing multi-modal transportation has additional cobenefits including improved air quality, which can reduce contributions to climate change and exposure to pollutants associated with a number of health problems including asthma, lung cancer, and heart disease.

#### Response: Comment acknowledged, thank you.

#### Healthy building design standards:

Building design can impact health in several ways including through the materials used and the amount of volatile organic compounds (VOCs) or other harmful chemicals that they contain, the air and water quality, the amount of daylight available, and even by encouraging physical activity and social interaction. TCHD encourages the applicant

to consider incorporating design standards into the development to ensure a health promoting environment. The applicant could pursue building certifications such as LEED, WELL Building Standard, Certified Healthy, or Living Building Challenge.

#### Response: Comment acknowledged, thank you.

#### Connections to Transit:

Communities that promote walking, bicycling and transit trips can also help protect air quality by reducing vehicle trips and related emissions. TCHD supports projects that address the needs of groups (e.g., seniors, the disabled) who cannot or do not drive. Transit-friendly developments can make it easier for these groups to access services and to maintain connections within the community, which can also have health benefits. Since research has shown that people who use transit regularly gain tremendous health benefits, TCHD commends the applicant for incorporating opportunities for increased pedestrian transportation from public transit to the single-family attached townhomes.

### Response: Comment acknowledged, thank you.

#### Community Design to Support Community Connection

The way communities are designed can influence mental health and social connections. By providing community amenities, social interaction is supported and residents can build social capital which has known positive health effects. The incorporation of features like landscaping and green space can also reduce stress and promote positive psychological benefits. Because of this, TCHD encourages community designs that incorporate green space and common areas. We strongly support the applicant's plans to include pedestrian amenities such as a tot lot, lawn area and internal walks throughout the site.

#### Response: Comment acknowledged, thank you.

#### Attainable Housing

Access to safe, attainable housing is directly associated with positive physical and mental health outcomes and underlies one's ability to access jobs, food, medical services, and other essentials that are vital to well-being. Providing permanent supportive housing is an integral element of promoting health in our communities. TCHD supports projects that include an attainable housing component.

#### Response: Comment acknowledged, thank you.

#### Radon

Radon is a naturally occurring radioactive gas that is present at high levels in all parts of Colorado due to the presence of uranium in the soil. Radon can enter homes and longterm exposure causes lung cancer. In order to prevent radon from infiltrating the home, TCHD recommends designing new homes so that they are radon resistant. This includes laying a barrier beneath the flooring system, installing a gas-tight venting pipe from the gravel level through the roof, and sealing and caulking the foundation thoroughly. More information regarding radon and radon-resistant construction techniques can be found here: <u>https://www.epa.gov/radon/building-new-home-haveyou</u> considered-radon.

#### Response: Comment acknowledged, thank you.

#### Mosquito Control - Stormwater Facilities

The site plan indicates that a detention pond is proposed. Detention ponds can become sites for mosquito breeding. To reduce the potential for human exposures to West Nile and other mosquito-borne viruses, TCHD recommends that the applicant prepare a mosquito control plan. Elements of the plan should include proper design, construction

NORRIS DESIGN Planning | Landscape Architecture | Branding



and regular inspection and maintenance of stormwater quality facilities, and mosquito larvaciding if the insects become a problem. The applicant may submit the mosquito control plan to TCHD for review. More information is available here http://www.tchd.org/276/Mosquitoes-West-Nile-Virus. A guidance document is attached. *Response: Comment acknowledged, thank you.* 

# Comments Received by Donna George, Xcel Energy

Public Service Company of Colorado's (PSCo) Right of Way & Permits Referral Desk has determined there is a conflict with Berkeley Villas in that there are no dry utility easements shown on the preliminary plat. Please note that per state statutes, PSCo requests the following dry utility easements within each single-family residential lot:

- 6-feet wide for natural gas facilities with a minimum 5-foot clearance from any structure and where there is drivable pavement with space for service truck access (8-feet wide, 6- inches thick) with plowing in snowy conditions
- 8-feet wide for electric facilities including space for transformers, pedestals, and cabling
- if natural gas and electric are within the same trench, a 10-foot wide utility easement is required, not to overlap any wet utility easement
- bear in mind that these utility easements must have 5-feet of separation from gravity-fed wet utilities (typically sewer – going out of house) and 10-feet of separation from forcedfed water utilities (typically water – going into house)

#### Response: Comment noted, this will be addressed during Final Plat application.

Public Service Company requests that the following language or plat note is placed on the preliminary and final plats for the subdivision:

These easements are dedicated to Adams County for the benefit of the applicable utility providers for the installation, maintenance, and replacement of electric, gas, television, cable, and telecommunications facilities (Dry Utilities). Utility easements shall also be granted within any access easements and private streets in the subdivision. Permanent structures, improvements, objects, buildings, wells, and other objects that may interfere with the utility facilities or use thereof (Interfering Objects) shall not be permitted within said utility easements and the utility providers, as grantees, may remove any Interferin Objects at no cost to such grantees, including, without limitation, vegetation. Public Service Company of Colorado (PSCo) and its successors reserve the right to require additional easements and to require the property owner to grant PSCo an easement on its standard form.

#### Response: Note has been added per comment.

PSCo also requests that all tracts are available for utility use, particularly for crossing in order to maintain continuity throughout this development.


#### Response: Comment noted, thank you.

Please be aware PSCo has existing natural gas and electric distribution and service facilities within the subject property. The property owner/developer/contractor must complete the application process for any new natural gas or electric service, or modification to existing facilities including relocation and/or removal via xcelenergy.com/InstallAndConnect. It is then the responsibility of the developer to contact the Designer assigned to the project for approval of design details.

Response: Comment noted, thank you.



Additional easements will need to be acquired by separate document for new facilities (i.e. transformers) – be sure to have the Designer contact a Right-of-Way and Permits Agent. *Response: Comment noted, thank you.* 

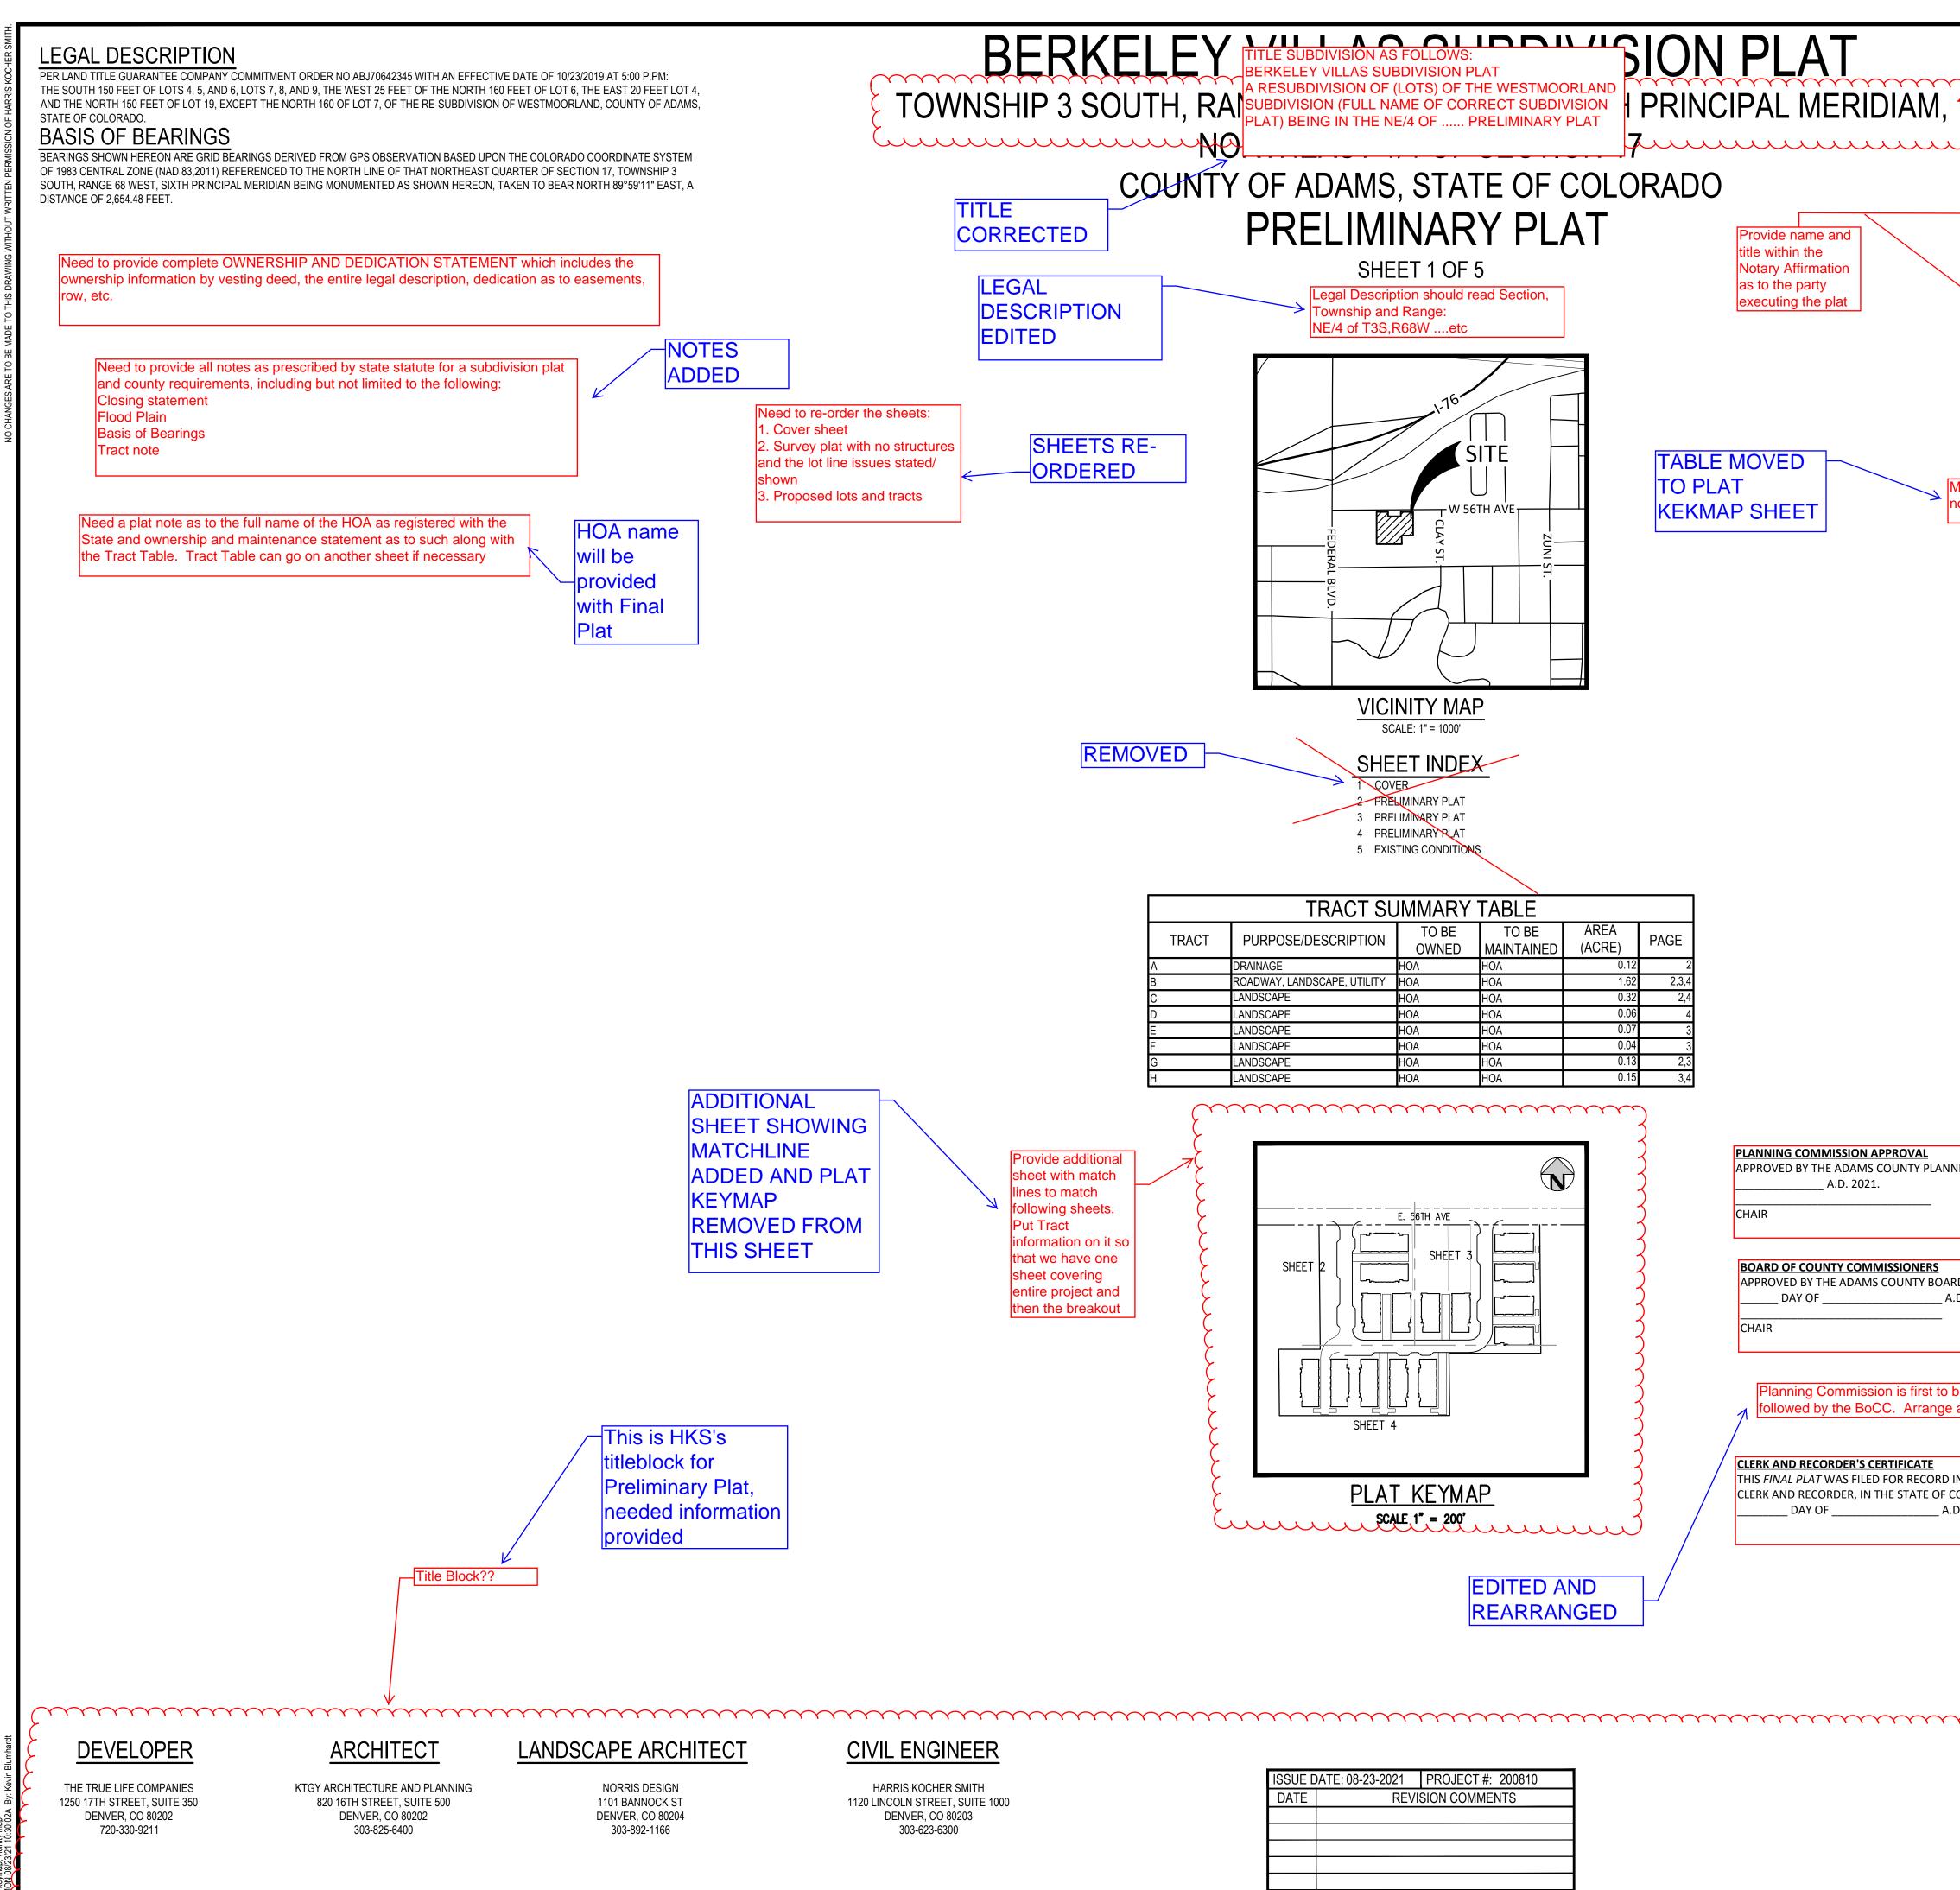



l	G	N	E	E	R	

ISSUE D	DATE: 08-23-2021	PROJECT #: 200810
DATE	REVI	SION COMMENTS

	PRC2021-00003
Correct typo correct title of subdivision plat	CASE Case Number Case Number PRC2021-0003
	KNOW ALL MEN BY THESE PRESENTS THAT (THE TRUE LIFE COMPANIES, BEING THE SOLE OWNER OF THE CRIBED TRACT OF LAND:
ABBREVIATIONS BOP BOTTOM OF PIPE	HAVE BY THESE PRESENTS LAID OUT, PLATTED AND SUBDIVIDED THE SAME INTO LOTS, STREETS AND EASEMENTS AS SHOWN ON THIS PLAT UNDER THE NAME AND STYLE OF TTLC DENVER - FEDERAL BLVD.
BS BOTTOM OF STEP BW BOTTOM OF WALL (FG) CONS CONCRETE DIA DIAMETER	BY: DATE: NAME: TITLE:
DIA DIAVIETER DIP DUCTILE IRON PIPE DR DOOR DS DOWNSPOUT E EAST, EASTING	ADAMS COUNTY STATE OF COLORADO
EGL ENERGY GRADE LINE EL ELEVATION EOA EDGE OF ASPHALT EOC EDGE OF CONCRETE	THE FOREGOING INSTRUMENT WAS ACKNOWLEDGED BEFORE ME THIS DAY OF AD 20, BY
EOP EDGE OF PAVEMENT love this table to another sheet ot on the Cover sheet	WITNESS MY HAND AND OFFICIAL SEAL. MY COMMISSION EXPIRES:
FF       FINISHED FLOOR         FG       FINISHED GRADE         FH       FIRE HYDRANT         FL       FLOW LINE	NOTARY PUBLIC
GBGRADE BREAKGVGATE VALVEHCHANDICAPHGLHYDRAULIC GRADE LINE	ADDRESS
HORZ HORIZONTAL HP HIGH POINT INV INVERT	SURVEYOR'S CERTIFICATION:
LP LOW POINT LSD LANDSCAPE DRAIN MAX MAXIMUM MH MANHOLE	I, AARON MURPHY, A REGISTERED LAND SURVEYOR IN THE STATE OF COLORADO, DO HEREBY CERTIFY THAT THE SURVEY FOR TTLC DENVER - FEDERAL BLVD SUBDIVISION PLAT WAS MADE UNDER MY SUPERVISION AND THE ACCOMPANYING PLAN ACCURATELY AND PROPERLY SHOWS SAID SURVEY.
MIN MINIMUM MJ MECHANICAL JOINT N NORTH, NORTHING PHS PHASE	Wet stamp and signature once prelim plat approved
PR PROPOSED PVC POLYVINYL CHLORIDE RCP REINFORCED CONCRETE PIPE	FOR AND ON BEHALF OF HARRIS KOCHER SMITH
ROW RIGHT-OF-WAY SAN SANITARY	APPROVALS: NOTED
SS SANITARY SEWER STA STATION STM STORM	APPROVED BYDATE FOR THE BOARD OF COUNTY COMMISSIONERS
TBTHRUST BLOCKTBCTOP/BACK OF CURBTOPTOP OF PIPE	APPROVED BYDATE
TS TOP OF STEP TW TOP OF WALL (FG) TYP TYPICAL	
UG UNDERGROUND VERT VERTICAL WAT WATER	CLERK & RECORDER'S CERTIFICATION:
ING COMMISSION THIS DAY OF	COUNTY OF ADAMS I HEREBY, CERTIFY THAT THIS INSTRUMENT WAS FILED FOR RECORD IN MY OFFICE ATO'CLOCKM.,20, AND DULY RECORDED
	UNDER RECEPTION #
l	BYDEPUTY
D OF COUNTY COMMISSIONERS THIS D. 2021.	FEE
	DEDICATION STATEMENTS:
e accepted as such	THE UNDERSIGNED DOES HEREBY DEDICATE, GRANT AND CONVEY TO ADAMS COUNTY THOSE PUBLIC EASEMENTS (AND TRACTS) AS SHOWN ON THE PLAT; AND FURTHER RESTRICTS THE USE OF ALL PUBLIC EASEMENT TO ADAMS COUNTY AND/OR ITS ASSIGNS, PROVIDED HOWEVER, THAT THE SOLE RIGHT AND AUTHORITY TO RELEASE OR QUITCLAIM ALL OR ANY SUCH PUBLIC EASEMENTS SHALL REMAIN EXCLUSIVELY VESTED IN ADAMS COUNTY.
N THE OFFICE OF THE ADAMS COUNTY	ALL PRIVATE STREETS (ROADS A, B & C) ARE PRIVATELY OWNED AND MAINTAINED BY TTLC DENVER - FEDERAL BLVD
OLORADO, AT M., ON THE 0. 2021.	STATEMENT RESTRICTING ACCESS: PUBLIC ACCESS ACROSS RIGHT-OF-WAY LINES, INCLUDING 56TH AVENUE, IS RESTRICTED.
	STORM DRAINAGE FACILITIES STATEMENT: THE POLICY OF THE COUNTY REQUIRES THAT MAINTENANCE ACCESS SHALL BE PROVIDED TO ALL STORM DRAINAGE
$\cdots \cdots $	FACALITIES TO ASSURE CONTINIOUS OPERATIONAL CAPABILITY OF THE SYSTEM. THE PROPERTY OWNERS SHALL BE RESPONSIBLE FOR THE MAINTANENCE OF ALL DRAINAGE FACILITIES INCLUDING INLETS, PIPES, CULVERTS, CHANNELS, DITCHES, HYDRAULIC STRUCTURES, AND DETENTION BASINS LOCATED ON THEIR LAND UNLESS MODIFIED BY THE SUBDIVISIOIN DEVELOPMENT AGREEMENT. SHOULD THE OWNER FAIL TO MAINTAIN SAID FACILITIES, THE COUNTY SHALL HAVE THE RIGHT TO ENTER SAID LAND FOR THE SOLE PURPOSE OF OPERATIONS AND MAINTENANCE. ALL SUCH MAINTENANCE COST WILL BE ASSESSED TO THE PROPERTY OWNERS.
	REMOVED
	REMOVED . Remove
<b>REVISION DATE:</b>	ISSUE DATE: 08-23-2021 SHEET 1 OF 5


BERKELEY VILLAS SUBDIVISION PLAT

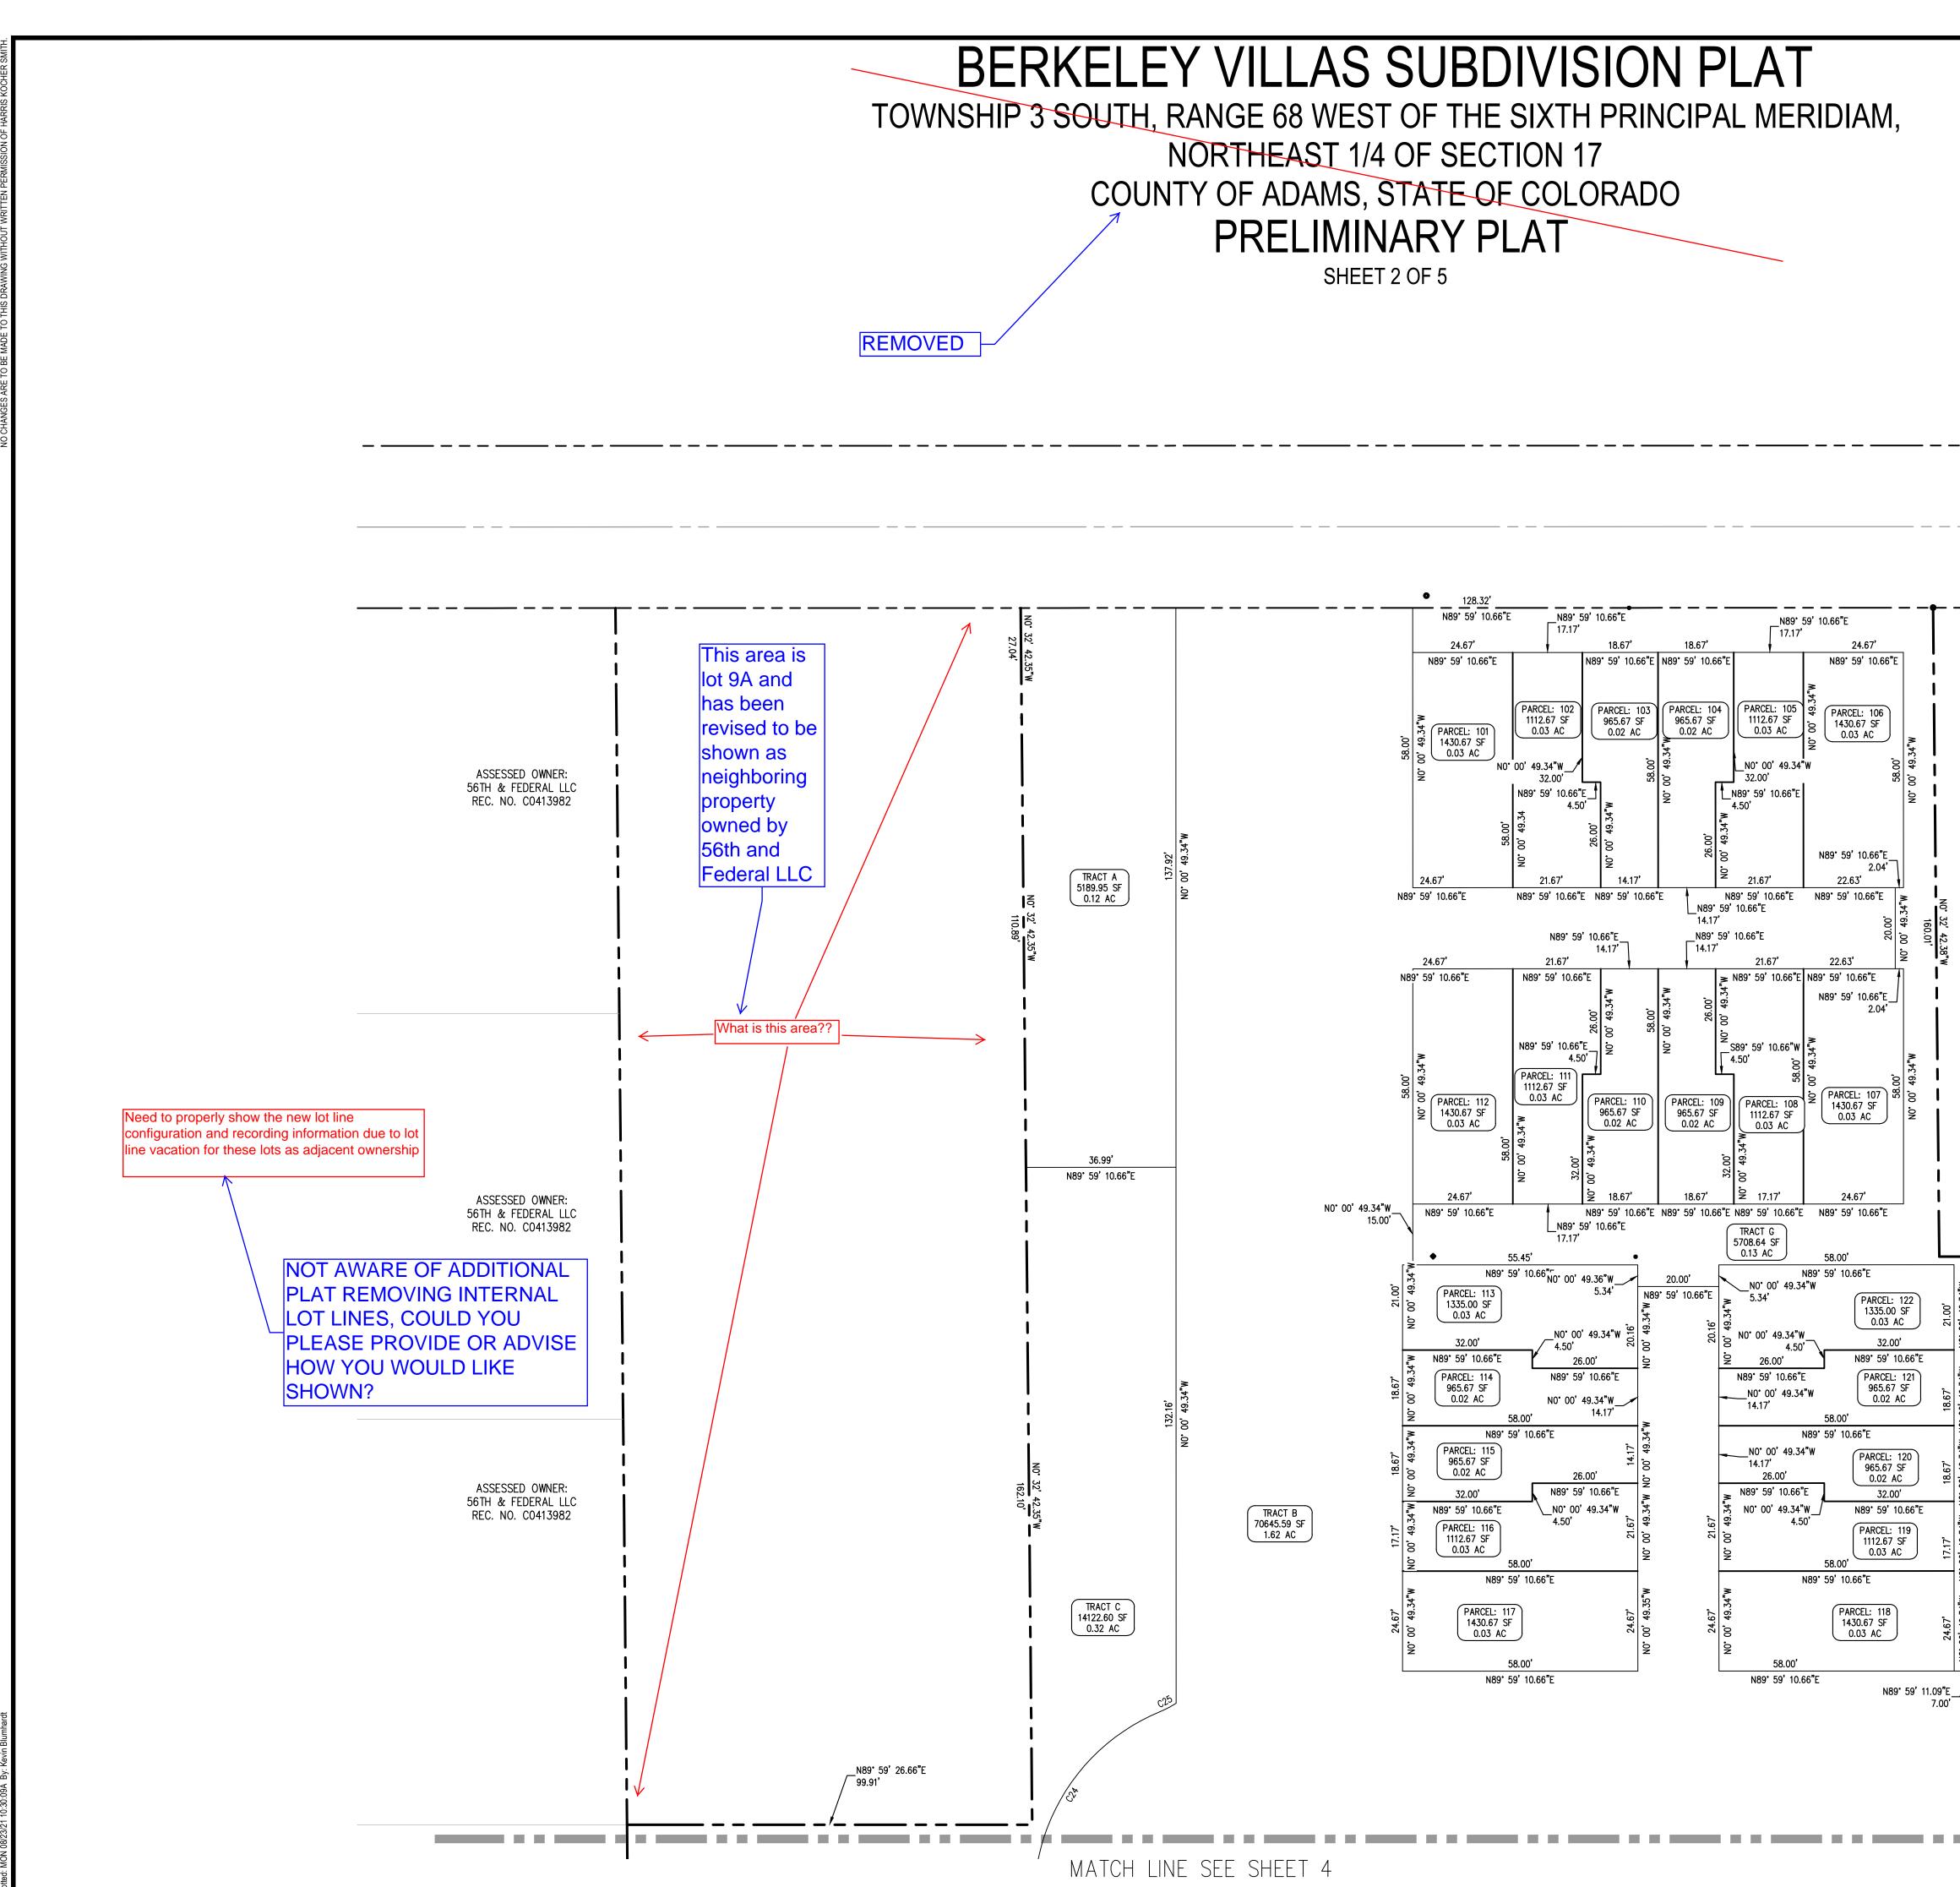

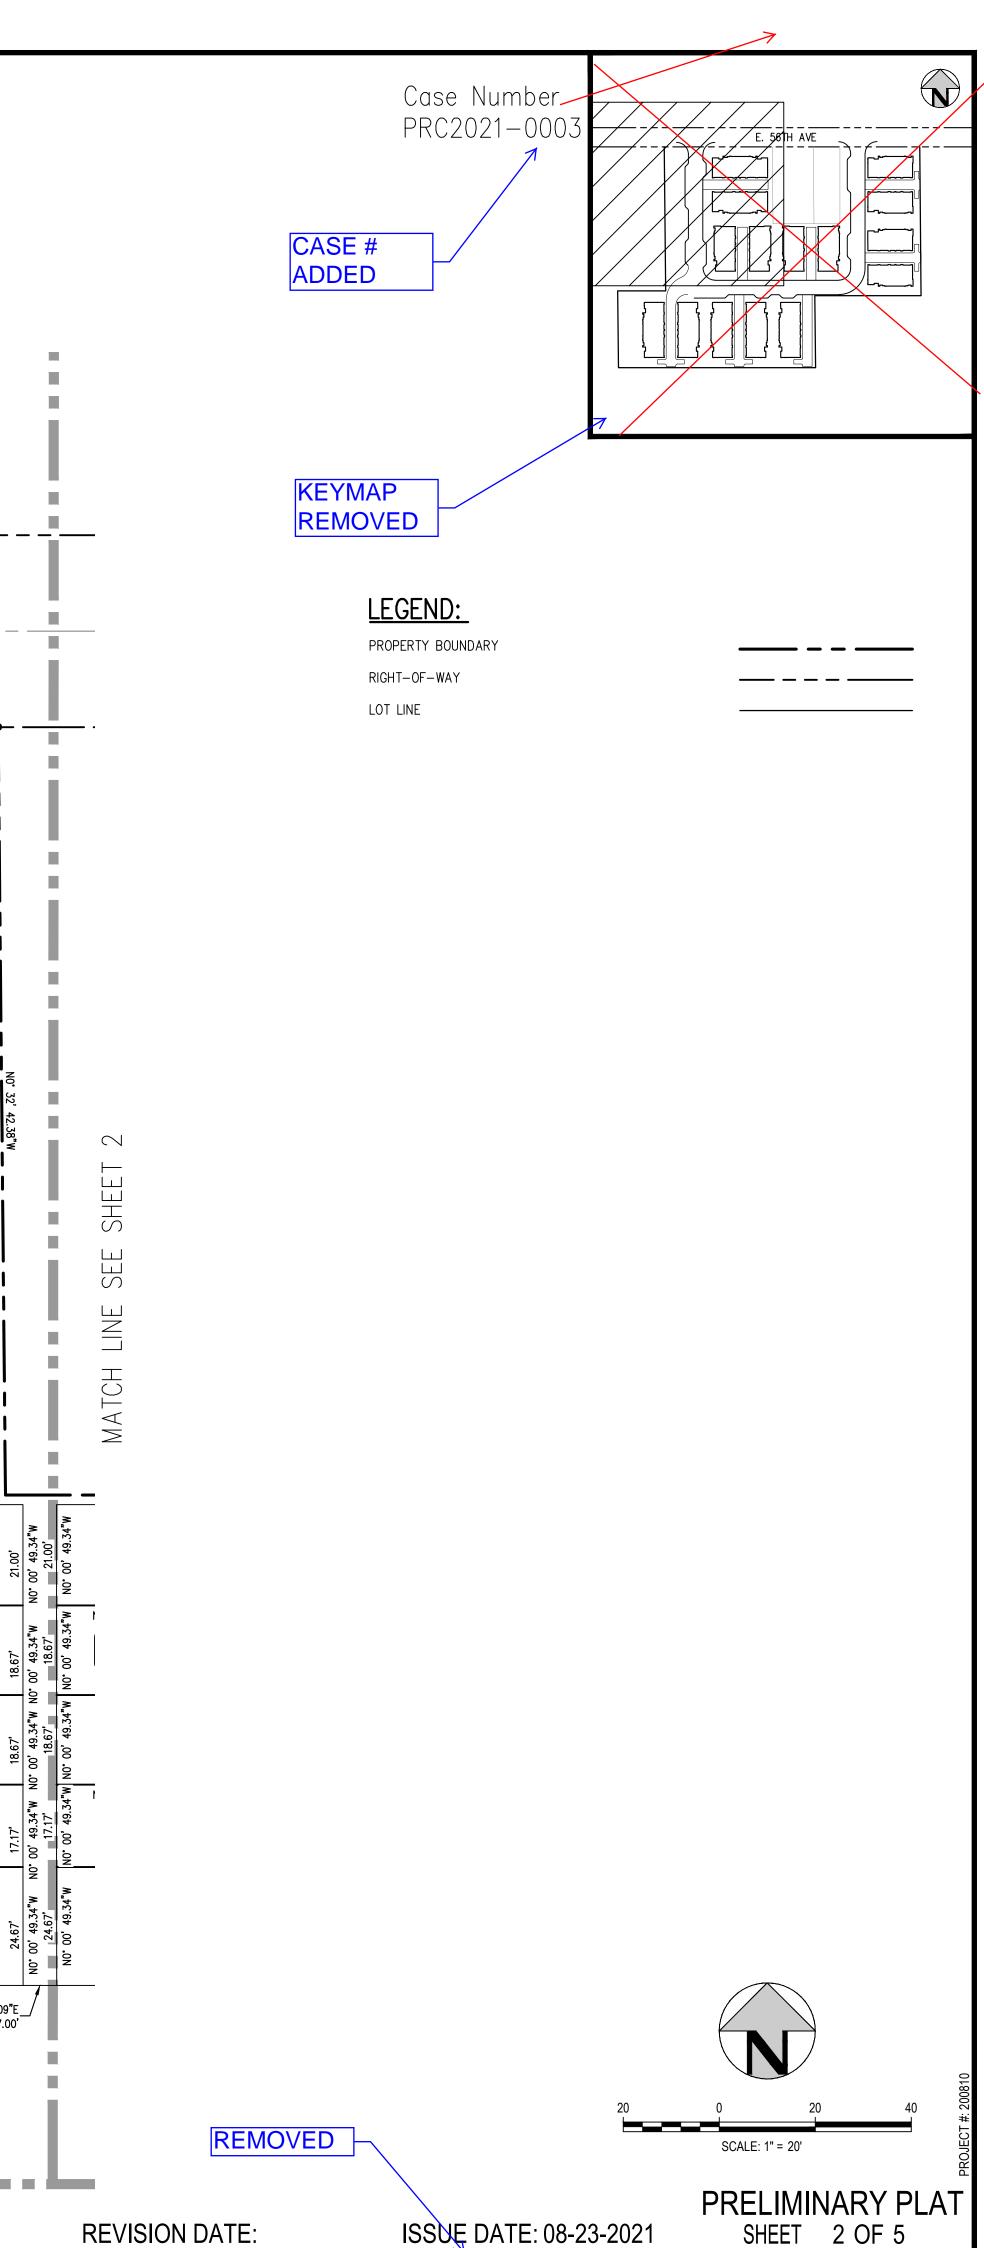



**REVISION DATE:** 

ISSUE DATE: 08-23-2021 **BERKELEY VILLAS SUBDIVISION PLAT** 

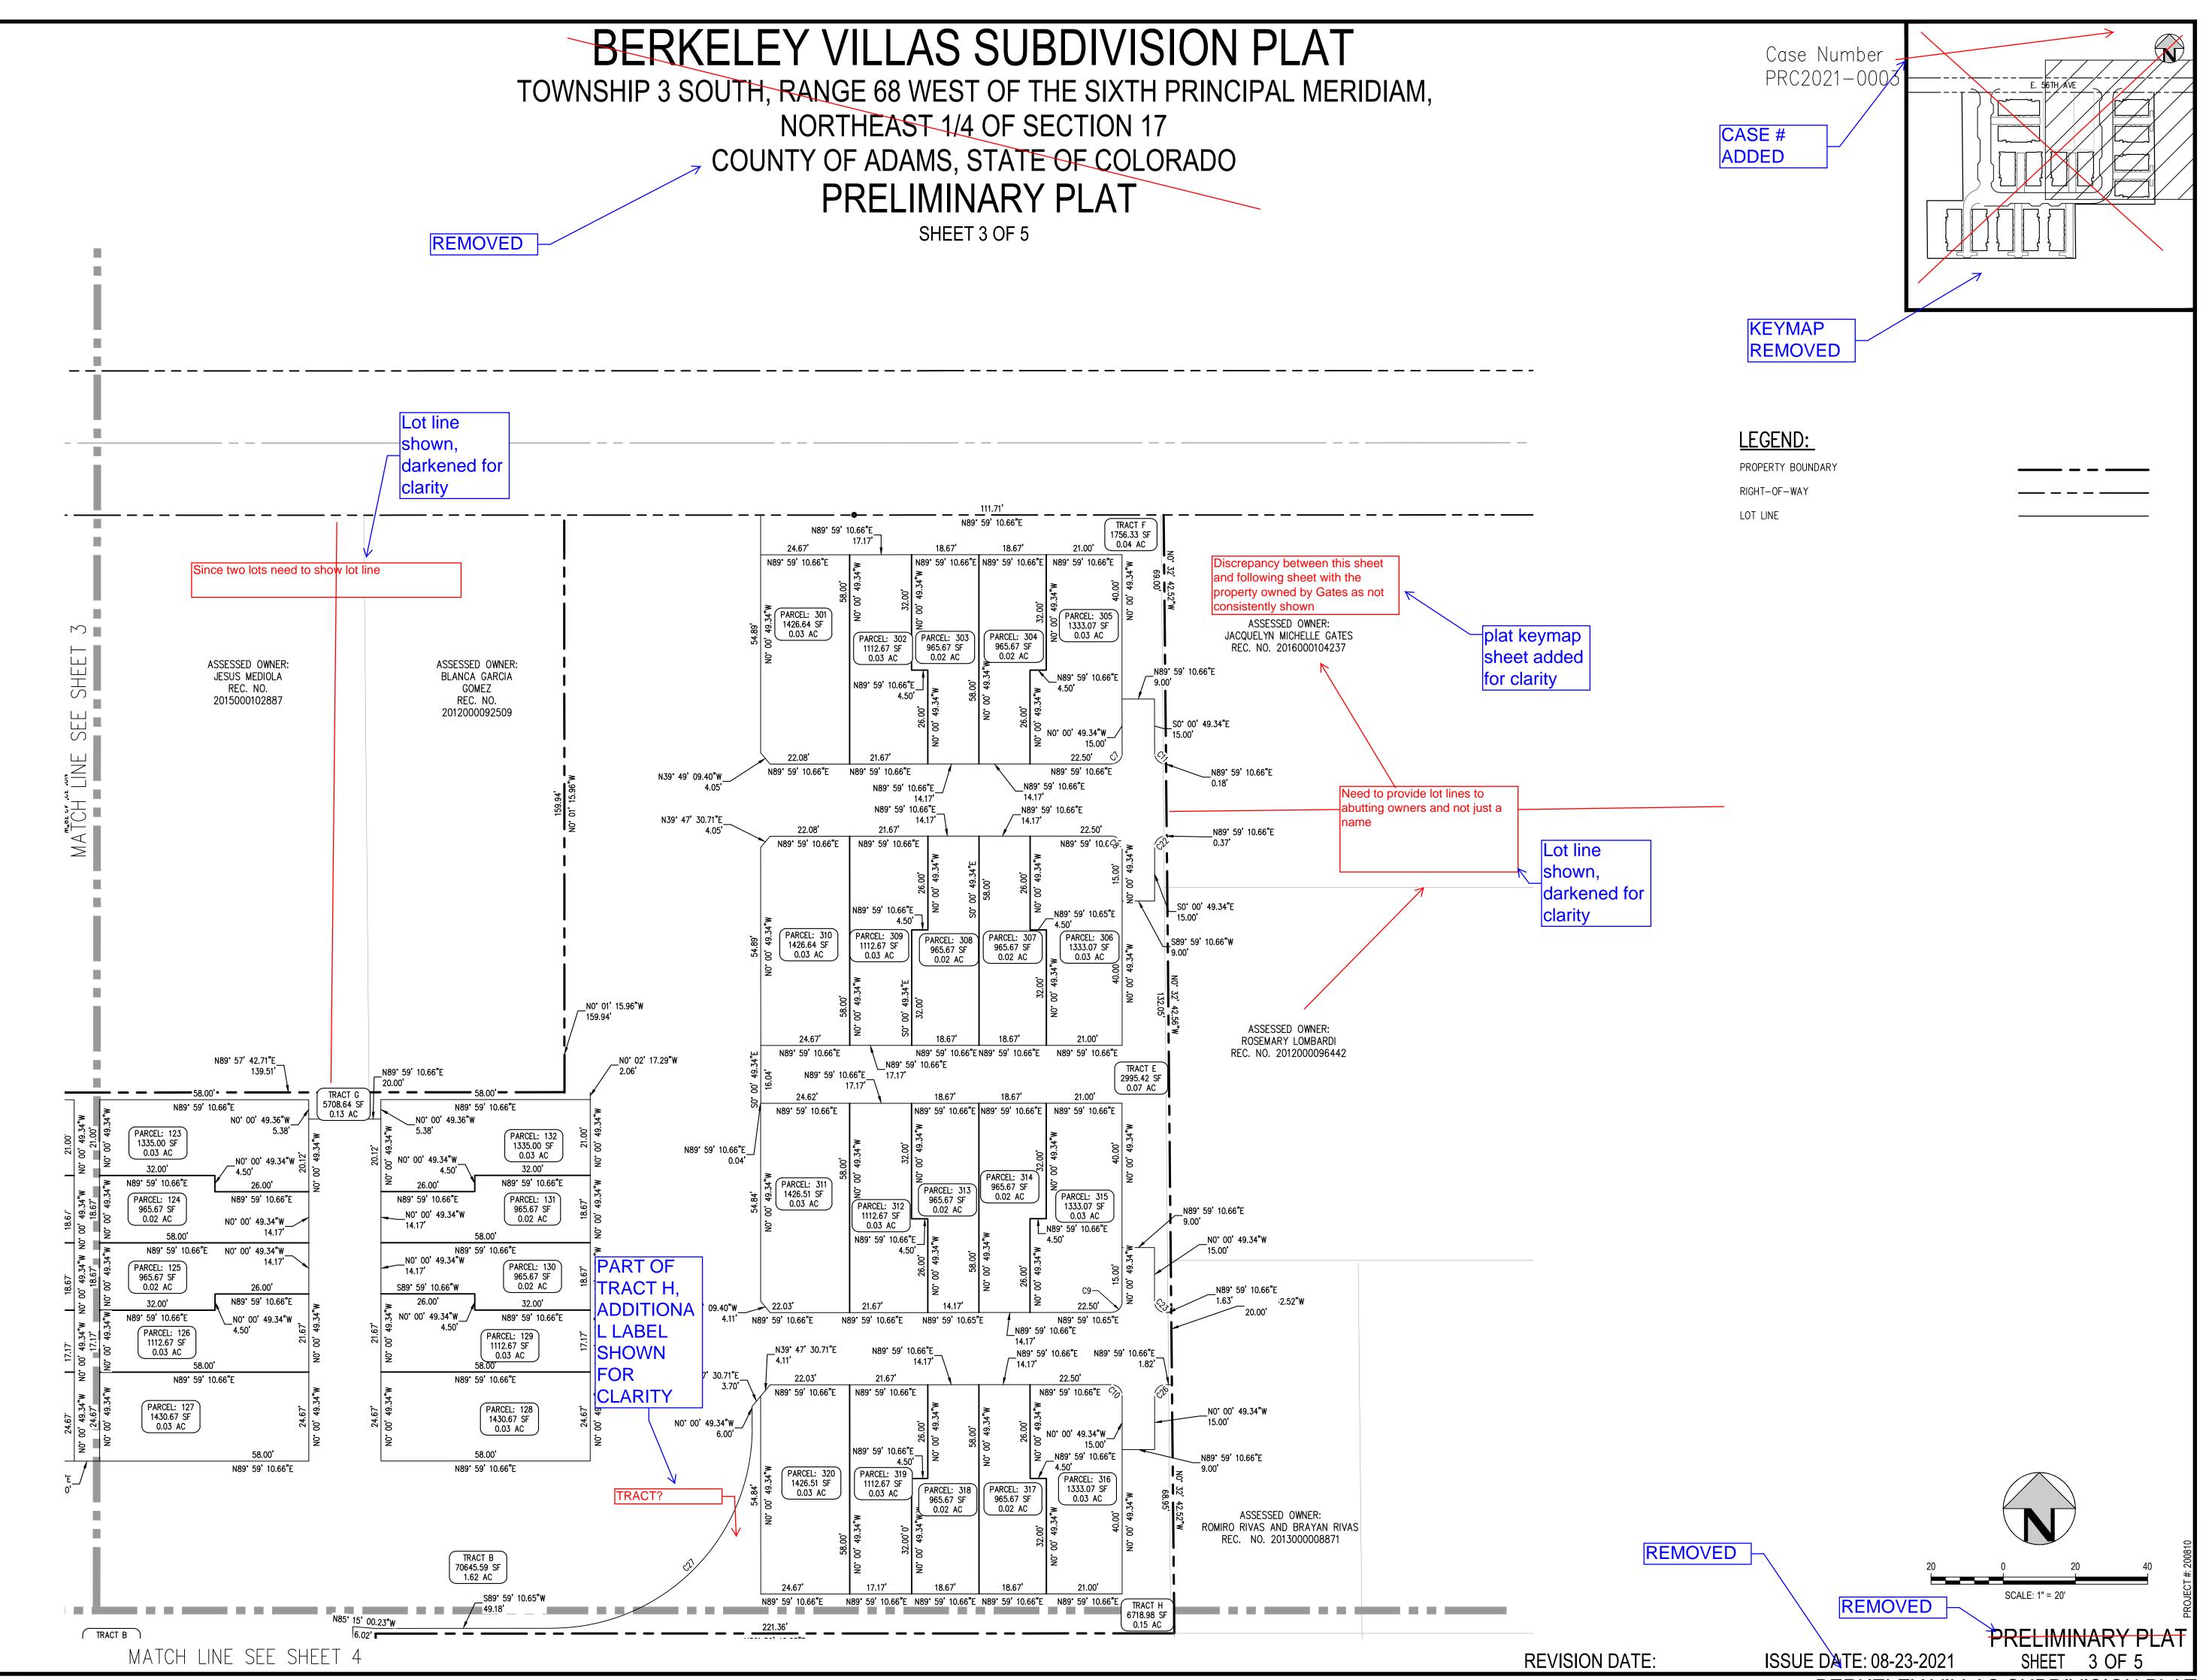

BERKELEY VILLAS SUBDIVISION PLAT

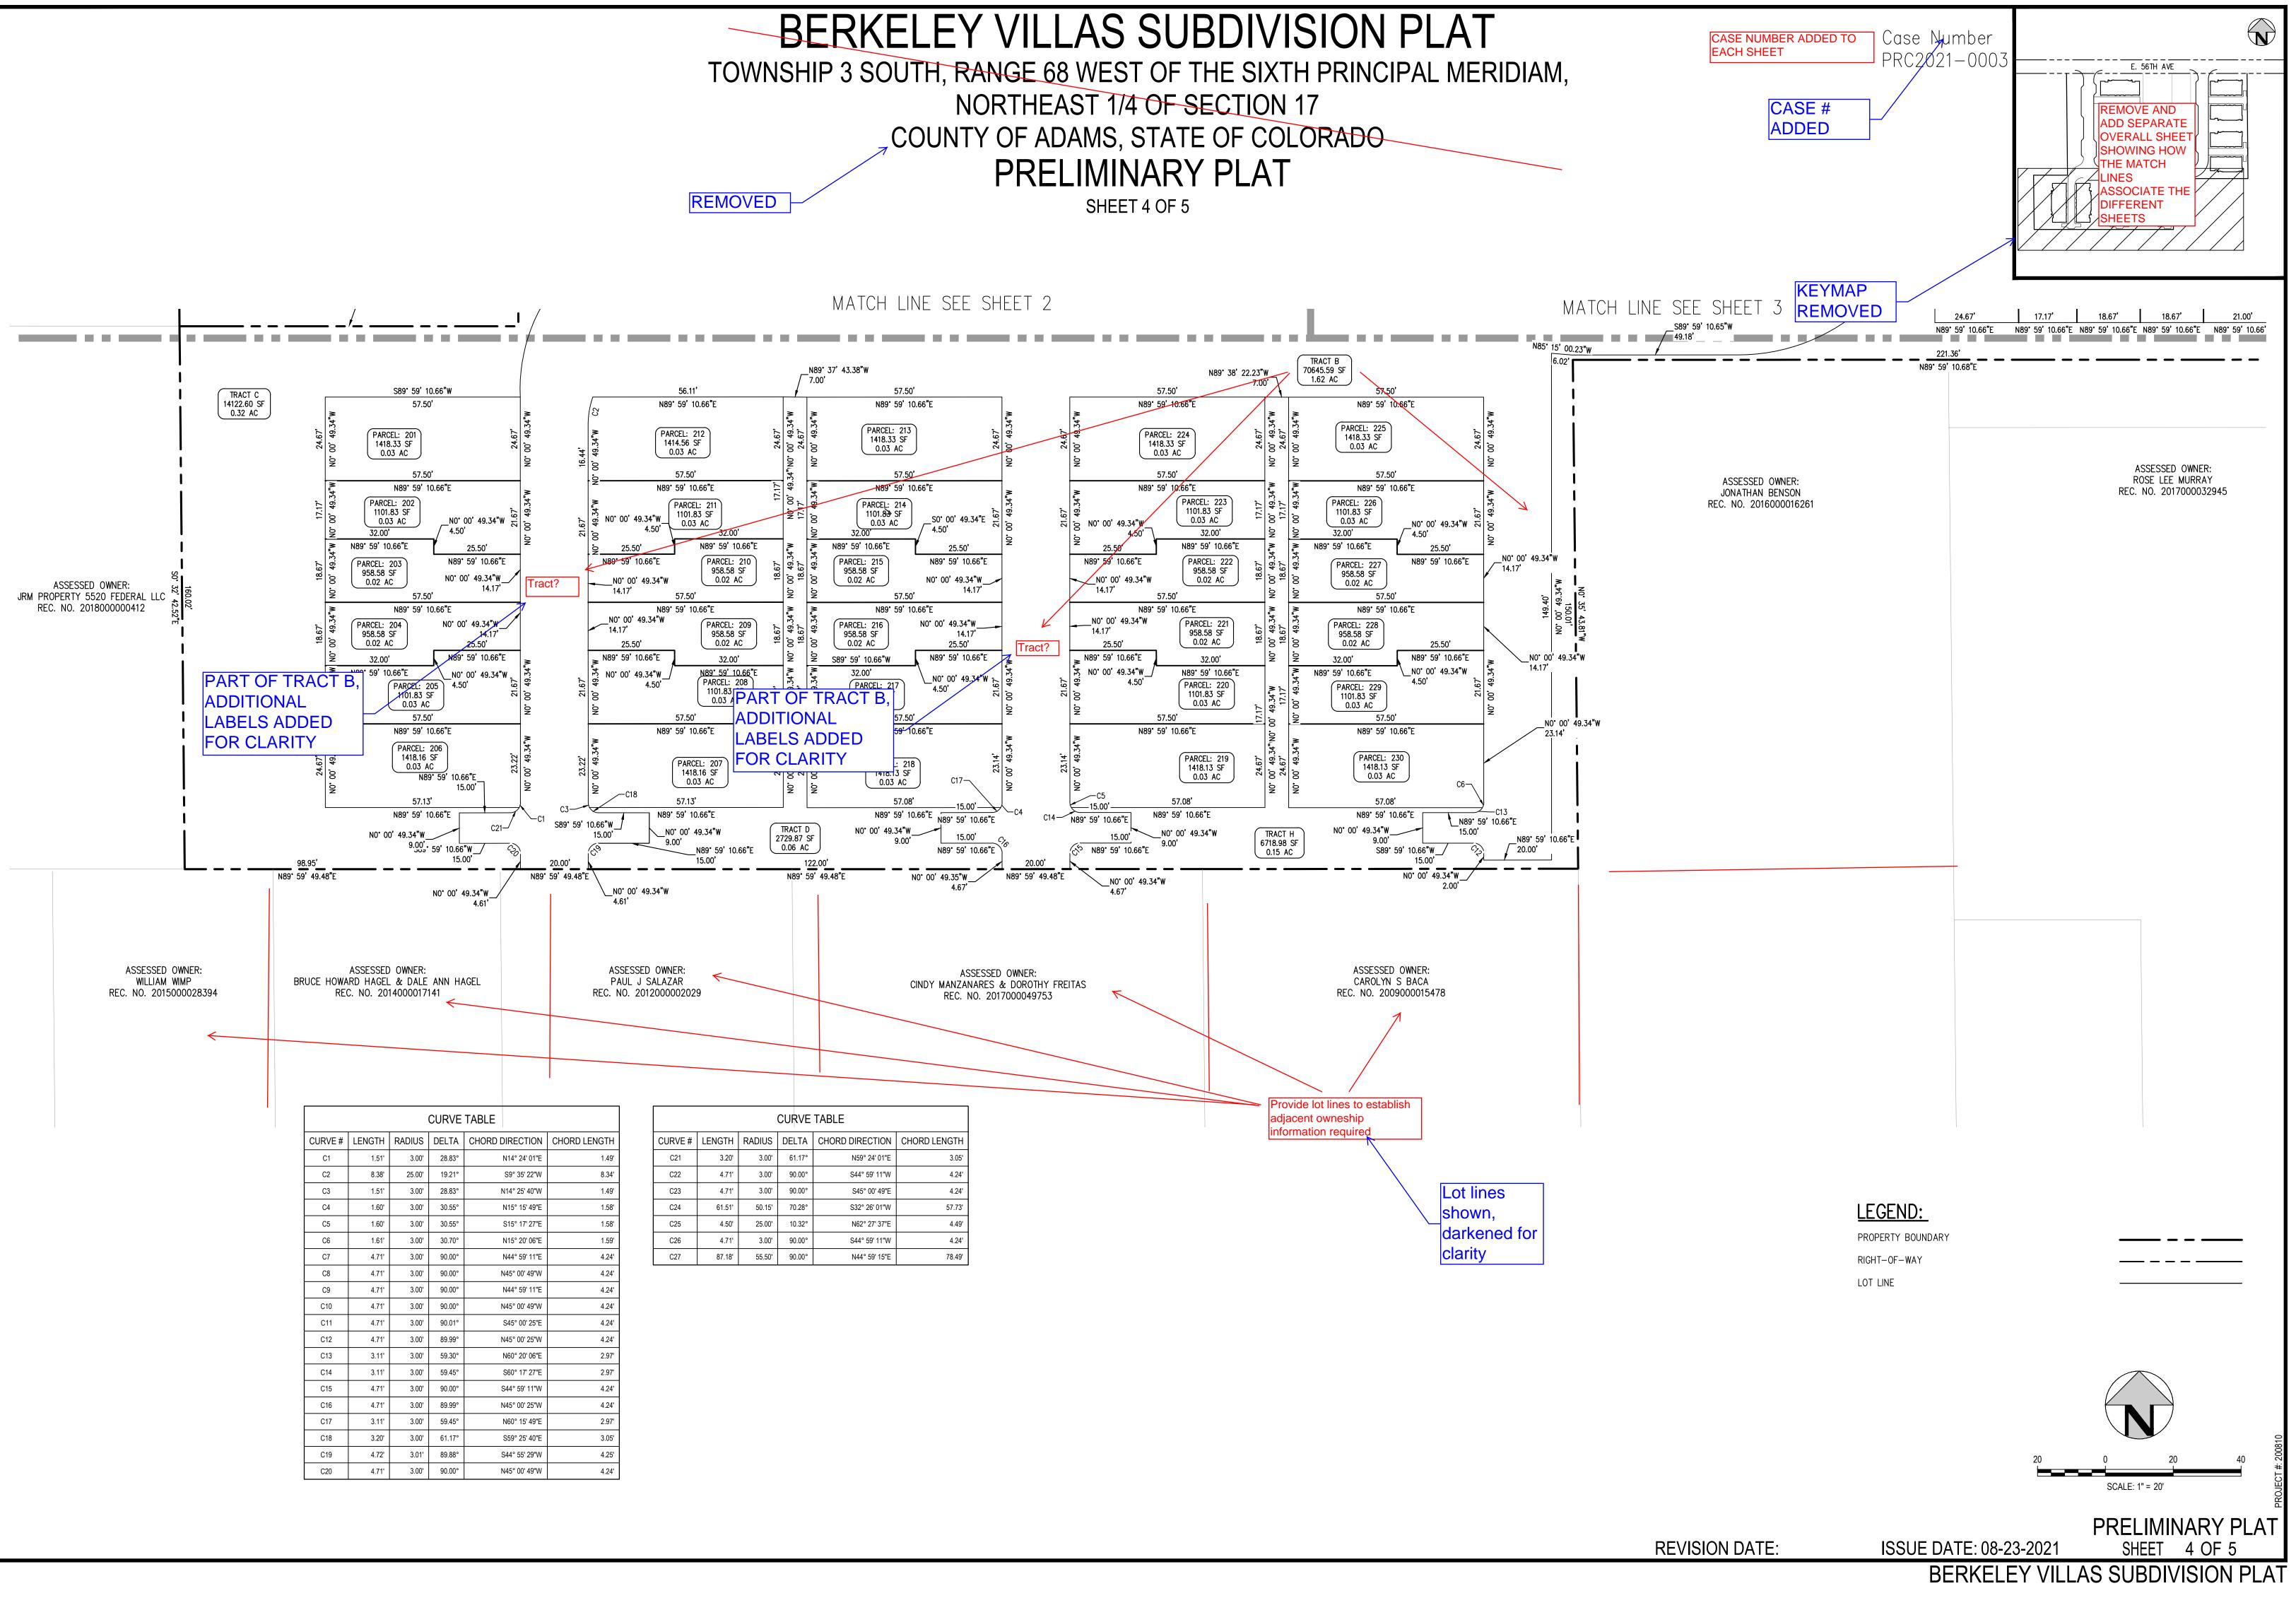

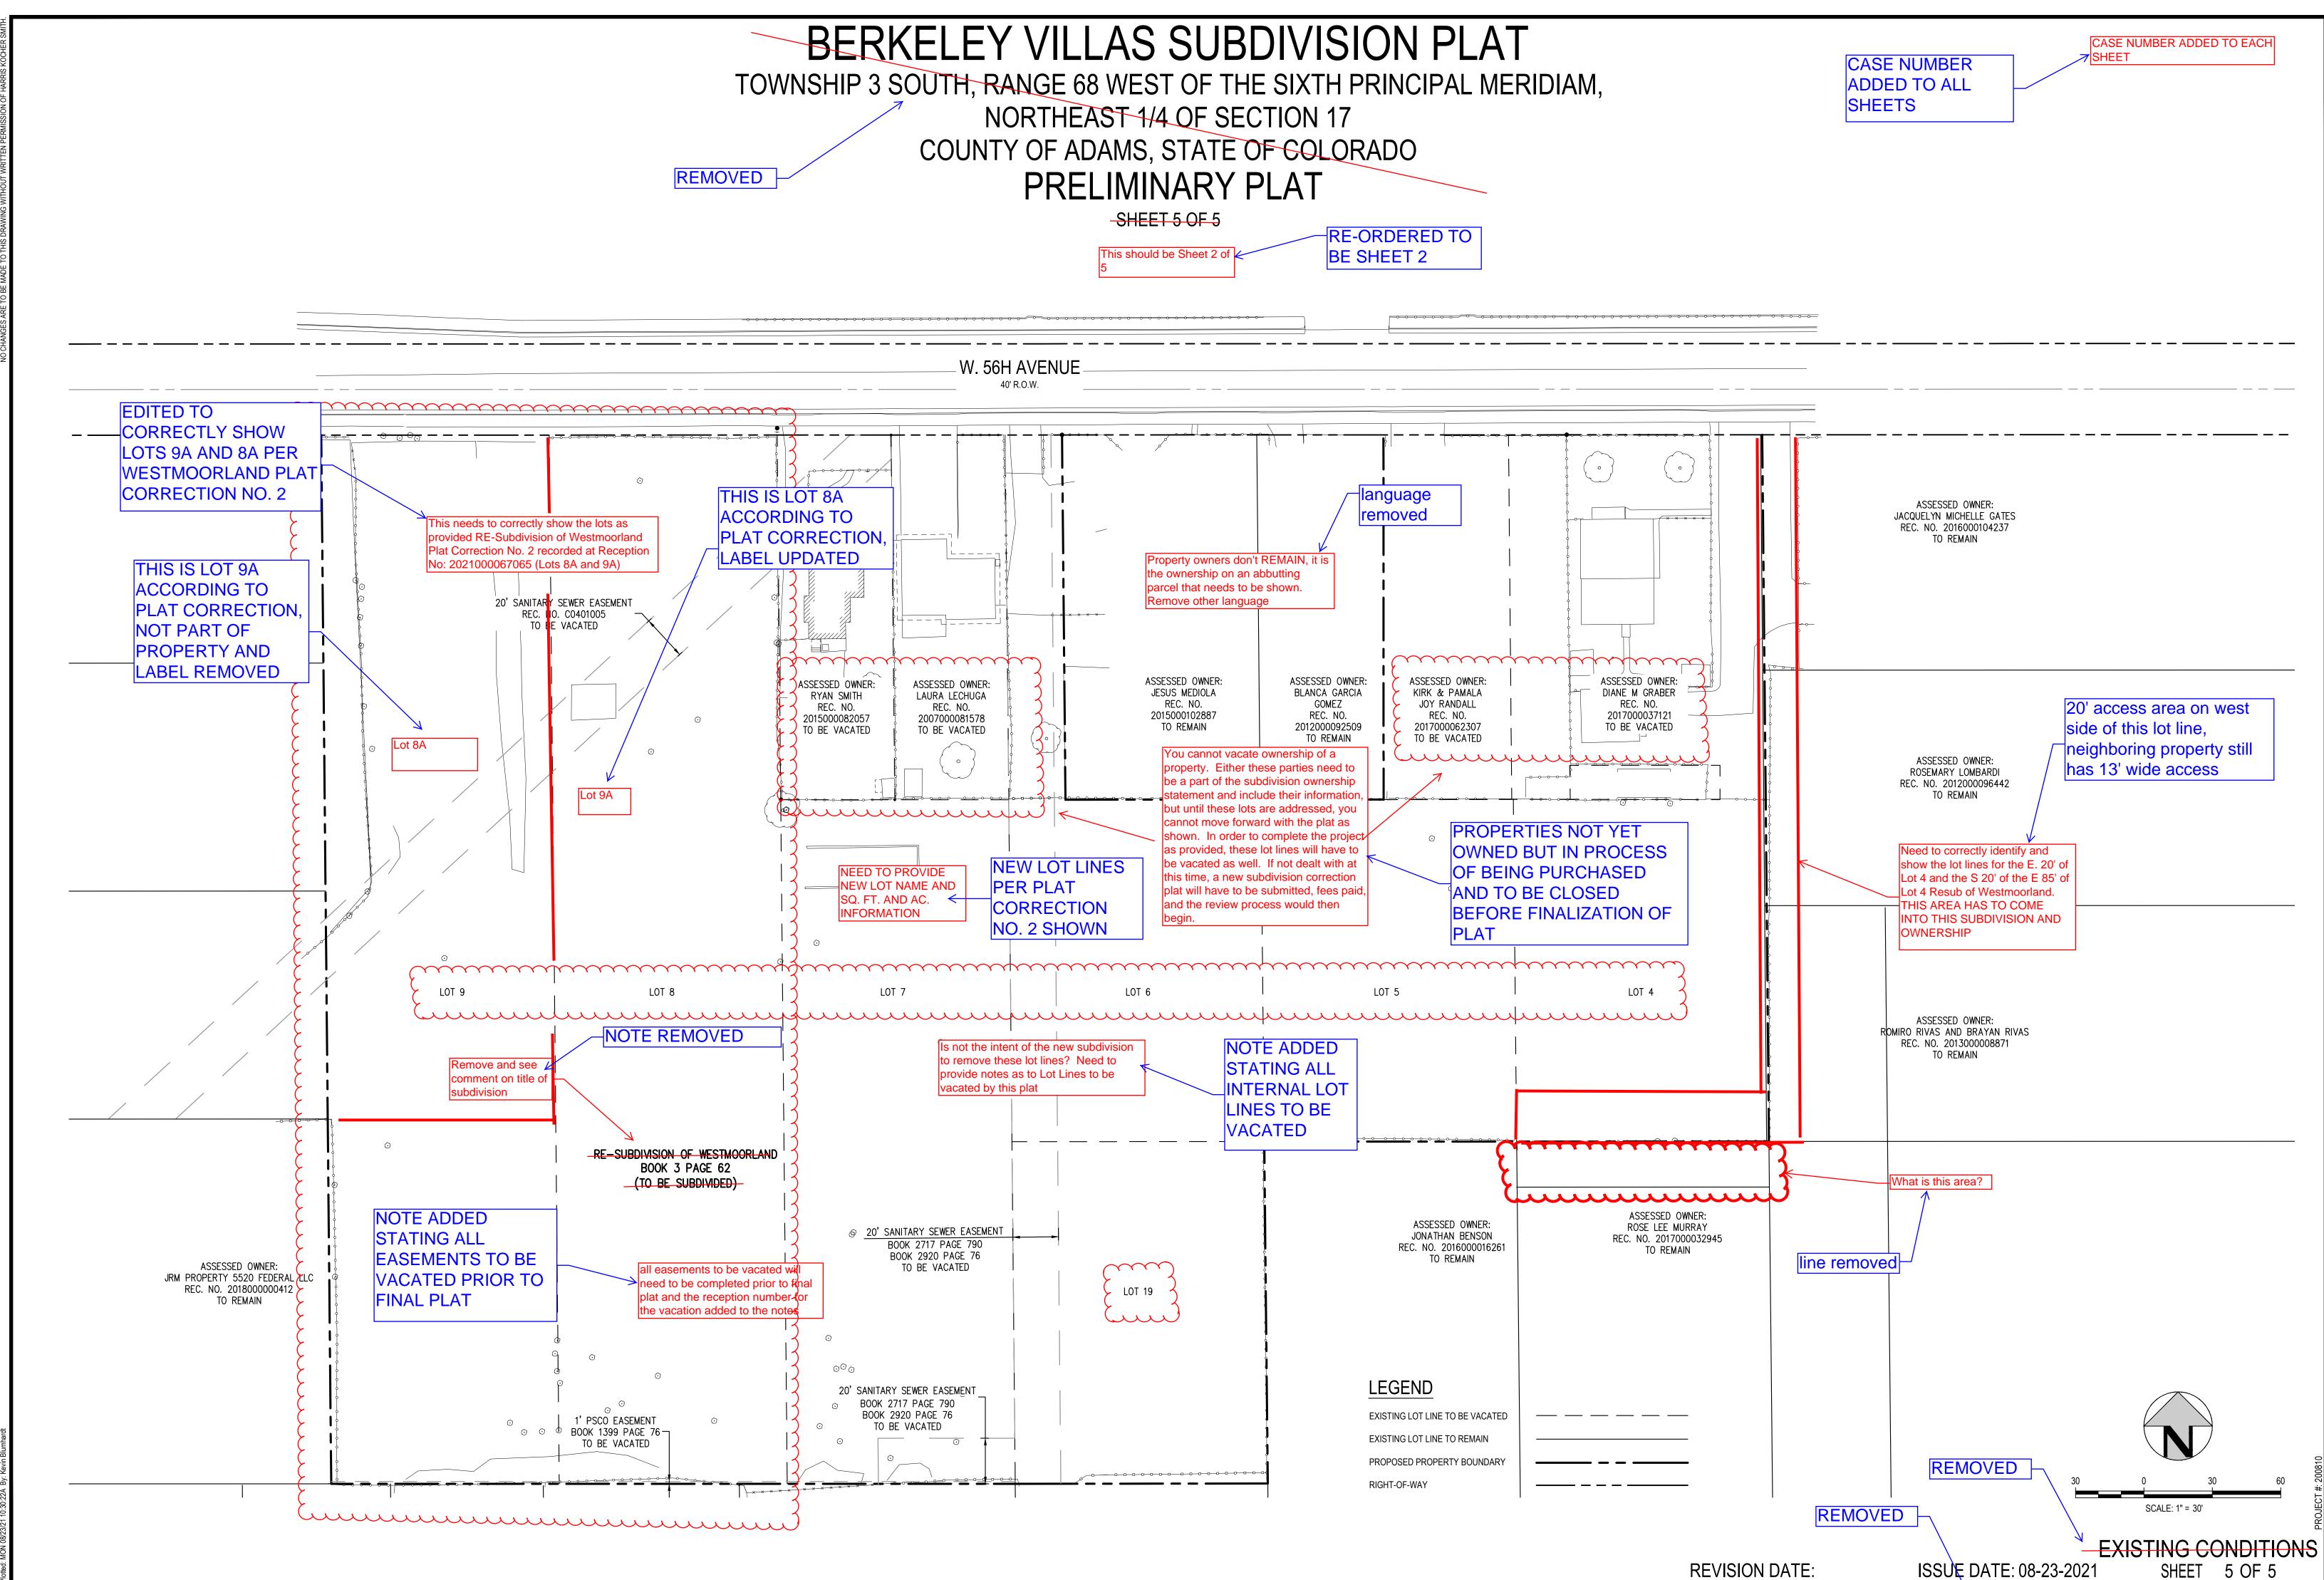

BERKELEY VILLAS SUBDIVISION PLAT

Community & Economic Development Department www.adcogov.org



4430 South Adams County Parkway 1st Floor, Suite W2000 Brighton, CO 80601-8204 рноме 720.523.6800 гах 720.523.6998

# **REZONING (Zoning Map Amendment)**

Application submittals must include all documents on this checklist as well as this page. Please use the reference guide (pg. 2) included in this packet for more information on each submittal item.

All applications shall be submitted electronically to <u>epermitcenter@adcogov.org</u>. If the submittal is too large to email as an attachment, the application may be sent as an unlocked OneDrive link. Alternatively, the application may be delivered on a flash drive to the One-Stop Customer Service Center. All documents should be combined in a single PDF. Once a complete application has been received, fees will be invoiced and payable online at <u>https://permits.adcogov.org/CitizenAccess/</u>.

- 1. Development Application Form (pg. 4)
- 2. Application Fees (see table)
- 3. Written Explanation of the Project
- 4. Site Plan Showing Proposed Development, including:
  - a. Proposed Building Envelope
  - b. Parking Areas
  - c. Site Access
  - d. Landscape Areas
- 5. Trip Generation Letter
- 6. Preliminary Drainage Analysis
- 7. Neighborhood Meeting Summary
- 8. Proof of Ownership (warranty deed or title policy)
- 9. Proof of Water and Sewer Services
- 10. Legal Description
- 11. Certificate of Taxes Paid
- 12.Certificate of Notice to Mineral Estate Owners/and Lessees (pg. 6)
- 13.Certificate of Surface Development (pg. 7)

Applications Fees	Amount	Due
Application	\$1,500	After complete application received
Tri-County Health	\$150 (public utilities-TCHD Level 1) \$210 (individual septic-TCHD Level 2)	After complete application received

# **Rezoning Guide to Development Application Submittal**

All development application submittals shall comprise of one (1) electronic copy (emailed or delivered on a USB). Application submittals that do not conform to these guidelines shall not be accepted.

# 3. Written Explanation of the Project:

• A clear and concise, yet thorough, description of the proposal. Please include, if applicable, timeframe, purpose of project, and improvements that will be made to the site

# 4. Site Plan Showing Proposed Development:

- A detailed drawing of existing and proposed improvements
- Including:
  - o Streets, roads, and intersections
  - Driveways, access points, and parking areas
  - Existing and proposed structures, wells, and septic systems,
  - Easements, utility lines, and no build or hazardous areas
  - Scale, north arrow, and date of preparation
- An Improvement Location Certificate or Survey <u>may be required</u> during the official review

# **5. Trip Generation Letter:**

• Shall be determined based upon the methodologies of the most current, Institute of Transportation Engineers (ITE) Trip Generation Manual for the weekday AM peak hour and weekday PM peak hour

# 6. Preliminary Drainage Analysis:

• A general narrative discussing the pertinent drainage characteristics and problems, and proposed drainage characteristics if the subdivision is approved

# 7. Neighborhood Meeting Summary:

- Please refer to Section 2-01-02 of the Adams County Development Standards and Regulations for the specific requirements regarding time, location, and notice
- A written summary shall be prepared including the materials submittal presented at the meeting, any issues identified at the meeting, and how those issues have been addressed

# 8. Proof of Ownership:

- A deed may be found in the Office of the Clerk and Recorder
- A title commitment is prepared by a professional title company

# 9. Proof of Water:

- Public utilities-A written statement from the appropriate water district indicating that they will provide service to the property **OR** a copy of a current bill from the service provider
- Private utilities- Well permit(s) information can be obtained from the Colorado State Division of Water Resources at (303) 866-3587

# **Proof of Sewer:**

- Public utilities-A written statement from the appropriate sanitation district indicating that they will provide service to the property **OR** a copy of a current bill from the service provider
- Private utilities-A written statement from Tri-County Health indicating the viability of obtaining Onsite Wastewater Treatment Systems

# **10. Legal Description:**

- Geographical description used to locate and identify a property
- Visit <u>http://gisapp.adcogov.org/quicksearch/</u> to find the legal description for your property

# 11. Certificate of Taxes Paid:

- All taxes on the subject property must be paid in full. Please contact the Adams County Treasurer's Office
- Or <u>http://adcogov.org/index.aspx?NID=812</u>

# 12. and 13. Certificate of Notice to Mineral Estate Owners/ Certificate of Surface Development:

- The State of Colorado requires notification to mineral rights owners of applications for surface development (i.e. zoning, plats, etc.)
- Mineral or Surface right owners may be found in the title commitment for the subject property
- You may also search the Office of the Clerk and Recorder for any recorded deeds, easements, or other documents.

Community & Economic Development Department www.adcogov.org



4430 South Adams County Parkway 1st Floor, Suite W2000 Brighton, CO 80601-8204 PHONE 720.523.6800 FAX 720.523.6998

# Application Type:

	ceptual Review Preliminary PUD division, Preliminary Final PUD	Tempor	-	
Sub	division, Final Rezone Correction/ Vacation Special Use	Condition	nal Use	
	56th and Federal			
APPLICANT				
Name(s):	David Clock / The True Life Companies	Phone #:	720-330-9211	
Address:	1350 17th Street, Suite 350			
City, State, Zip:	Denver, CO 80202			
2nd Phone #:		Email:	dclock@thetruelifecompanies.com	
OWNER				
Name(s):	TTL - Denver & Federal LLC	Phone #:	720-330-9211	
Address:	1566 Gilpin Street			
City, State, Zip:	Denver, CO 80218			
2nd Phone #:		Email:	dclock@thetruelifecompanies.com	
TECHNICAL REPRESENTATIVE (Consultant, Engineer, Surveyor, Architect, etc.)				
Name:	Eva Mather / Norris Design	Phone #:	303-892-1166	
Address:	1101 Bannock St.			
City, State, Zip:	Denver, CO 80204			
2nd Phone #:		Email:	emather@norris-design.com	

# **DESCRIPTION OF SITE**

Address:	2880 W. 56th Ave	
City, State, Zip:	Denver, CO 80221	
Area (acres or square feet):	0.02  AC + 0.3  AC = 0.32  AC Total	
Tax Assessor Parcel Number	0182517103053 / 0182517103052	
Existing Zoning:	R-2	
Existing Land Use:	Residential	
Proposed Land Use:	Urban Residential	
Have you attended a Conceptual Review? YES X NO		
If Yes, please list PRE#: 2019-00103		

I hereby certify that I am making this application as owner of the above described property or acting under the authority of the owner (attached authorization, if not owner). I am familiar with all pertinent requirements, procedures, and fees of the County. I understand that the Application Review Fee is non-refundable. All statements made on this form and additional application materials are true to the best of my knowledge and belief.

Name:	William Stolar	Date:	4/21/2021	
	Owner's Printed Name			
Name:	William Stolar 04/21/2021			

Owner's Signature

Community & Economic Development Department www.adcogov.org



4430 South Adams County Parkway 1st Floor, Suite W2000 Brighton, CO 80601-8204 рноме 720.523.6800 гах 720.523.6998

# Application Type:

Sub	ceptual ReviewPreliminary PUDdivision, PreliminaryFinal PUDdivision, FinalXRezone	Tempor	e
	Correction/ Vacation Special Use	Other: _	
APPLICANT			
Name(s):	David Clock / The True Life Companies	Phone #:	720-330-9211
Address:	1350 17th Street, Suite 350		
City, State, Zip:	Denver, CO 80202		
2nd Phone #:		Email:	dclock@thetruelifecompanies.com
OWNER			
Name(s):	Ryan Smith	Phone #:	
Address:	2902 W 56th Ave		
City, State, Zip:	Denver, CO 80221		
2nd Phone #:		Email:	
TECHNICAL REI	PRESENTATIVE (Consultant, Engir	neer, Surve	yor, Architect, etc.)
Name:	Eva Mather / Norris Design	Phone #:	303-892-1166
Address:	1101 Bannock St		
City, State, Zip:	Denver, CO 80204		
2nd Phone #:		Email:	emather@norris-design.com

# **DESCRIPTION OF SITE**

Address:	2905 W 56th Ave	
City, State, Zip:	Denver, CO 80221	
Area (acres or square feet):	0.19AC	
Tax Assessor Parcel Number	0182517103041	
Existing Zoning:	R-2	
Existing Land Use:	Residential	
Proposed Land Use:	Urban Residential	
Have you attended a Conceptual Review? YES X NO		
If Yes, please list PRE#: 2019-00103		

I hereby certify that I am making this application as owner of the above described property or acting under the authority of the owner (attached authorization, if not owner). I am familiar with all pertinent requirements, procedures, and fees of the County. I understand that the Application Review Fee is non-refundable. All statements made on this form and additional application materials are true to the best of my knowledge and belief.

Name:	Ryan Smith	Date:	04/21/2021	
	Owner's Printed Name			
Name:	Ryan Smith			

Owner's Signature

Community & Economic Development Department www.adcogov.org



4430 South Adams County Parkway 1st Floor, Suite W2000 Brighton, CO 80601-8204 рноме 720.523.6800 гах 720.523.6998

# Application Type:

	ceptual Review Preliminary PUD division, Preliminary Final PUD	Tempora	-
Sub	division, Final Rezone Correction/ Vacation Special Use	Conditio	
	56th and Federal		
APPLICANT			
Name(s):	David Clock / The True Life Companies	Phone #:	720-330-9211
Address:	1350 17th Street, Suite 350		
City, State, Zip:	Denver, CO 80202		
2nd Phone #:		Email:	dclock@thetruelifecompanies.com
OWNER			
Name(s):	Laura Lechuga	Phone #:	
Address:	2898 W 56th Ave		
City, State, Zip:	Denver, CO 80221		
2nd Phone #:		Email:	
	PRESENTATIVE (Consultant, Engin	eer, Surve	yor, Architect, etc.)
Name:	Eva Mather / Norris Design	Phone #:	303-892-1166
Address:	1101 Bannock St		
City, State, Zip:	Denver, CO 80204		
2nd Phone #:		Email:	emather@norris-design.com

# **DESCRIPTION OF SITE**

Address:	2898 W 56th Ave	
City, State, Zip:	Denver, CO 80221	
Area (acres or square feet):	.15 AC	
Tax Assessor Parcel Number	0182517103038	
Existing Zoning:	R-2	
Existing Land Use:	Residential	
Proposed Land Use:	Urban Residential	
Have you attended a Conceptual Review? YES X NO		
If Yes, please list PRE#: 2019-00103		

I hereby certify that I am making this application as owner of the above described property or acting under the authority of the owner (attached authorization, if not owner). I am familiar with all pertinent requirements, procedures, and fees of the County. I understand that the Application Review Fee is non-refundable. All statements made on this form and additional application materials are true to the best of my knowledge and belief.

Name:	Laura Lechuga	Date:	4/21/2021
	Owner's Printed Name		
Name:	LAURA LECHUÇA 04/21/2021		

Owner's Signature

Community & Economic Development Department www.adcogov.org



4430 South Adams County Parkway 1st Floor, Suite W2000 Brighton, CO 80601-8204 рноме 720.523.6800 гах 720.523.6998

# Application Type:

Conceptual Review	Preliminary PUD	Temporary Use
Subdivision, Preliminary	Final PUD	Variance
Subdivision, Final	x Rezone	Conditional Use
Plat Correction/ Vacation	Special Use	Other:
PROJECT NAME: 56th and Federal		

# APPLICANT

City, State, Zip:

ZINI PINNE #.

Denver, CO 80204

Name(s):	David Clock / The True Life Companies	Phone #:	720-330-9211
Address:	1350 17th Street, Suite 350		
City, State, Zip:	Denver, CO 80202		
2nd Phone #:		Email:	dclock@thetruelifecompanies.com
OWNER			
Name(s):	Diane Graber	Phone #:	720-353-9078
Address:	2860 W. 56th Ave		
City, State, Zip:	Denver, CO 80221		
2nd Phone #		Email	Fourcoyne @ gmail. Com
TECHNICAL REI	PRESENTATIVE (Consultant, Eng	ineer, Surve	yor, Architect, etc.)
Name:	Eva Mather / Norris Design	Phone #:	303-892-1166
Address:	1101 Bannock St		

cilidii.

emamer@norns-design.com

### **DESCRIPTION OF SITE**

Address:	2860 W. 56th Ave	
City, State, Zip:	Denver, CO 80221	
Area (acres or square feet):	0.23 AC	
Tax Assessor Parcel Number	0182517103030	
Existing Zoning:	R-2	
Existing Land Use:	Residential	
Proposed Land Use:	Urban Residential	
Have you attended a Conceptual Review? YES X NO		
If Yes, please list PRE#: 2019-00103		

I hereby certify that I am making this application as owner of the above described property or acting under the authority of the owner (attached authorization, if not owner). I am familiar with all pertinent requirements, procedures, and fees of the County. I understand that the Application Review Fee is non-refundable. All statements made on this form and additional application materials are true to the best of my knowledge and belief.

Name:

Gneber Diane

Date: 428202

**Owner's Printed Name** 

Name:

the

Owner's Signature

Community & Economic Development Department www.adcogov.org



4430 South Adams County Parkway 1st Floor, Suite W2000 Brighton, CO 80601-8204 рноме 720.523.6800 гах 720.523.6998

# Application Type:

Sub	ceptual ReviewPreliminary PUDdivision, PreliminaryFinal PUDdivision, FinalRezoneCorrection/ VacationSpecial Use		-
APPLICANT			
Name(s):	David Clock / The True Life Companies	Phone #:	720-330-9211
Address:	1350 17th Street, Suite 350		
City, State, Zip:	Denver, CO 80202		
2nd Phone #:		Email:	dclock@thetruelifecompanies.com
OWNER			
Name(s):	56th and Federal LLC	Phone #:	720-330-9211
Address:	1566 Gilpin Street		
City, State, Zip:	Denver, CO 80218		
2nd Phone #:		Email:	dclock@thetruelifecompanies.com
TECHNICAL REI	PRESENTATIVE (Consultant, Engin	eer, Surve	yor, Architect, etc.)
Name:	Eva Mather / Norris Design	Phone #:	303-892-1166
Address:	1101 Bannock St.		
City, State, Zip:	Denver, CO 80204		
2nd Phone #:	303-883-4344	Email:	emather@norris-design.com

# **DESCRIPTION OF SITE**

Address:	2922 W. 56th Ave		
City, State, Zip:	Denver, CO 80221		
Area (acres or square feet):	4.22  AC + 0.17  AC = 4.39  AC  TOTAL		
Tax Assessor Parcel Number	0182517103051 / 0182517103050		
Existing Zoning:	R-2		
Existing Land Use:	Residential		
Proposed Land Use:	Urban Residential		
Have you attende	Have you attended a Conceptual Review? YES X NO		
f Yes, please list PRE#: 2019-00103			


I hereby certify that I am making this application as owner of the above described property or acting under the authority of the owner (attached authorization, if not owner). I am familiar with all pertinent requirements, procedures, and fees of the County. I understand that the Application Review Fee is non-refundable. All statements made on this form and additional application materials are true to the best of my knowledge and belief.

Name:	William Sto	William Stolar		4/21/2021	
	Owner's	Printed Name			
Name:	William Stolar	04/21/2021			

Owner's Signature





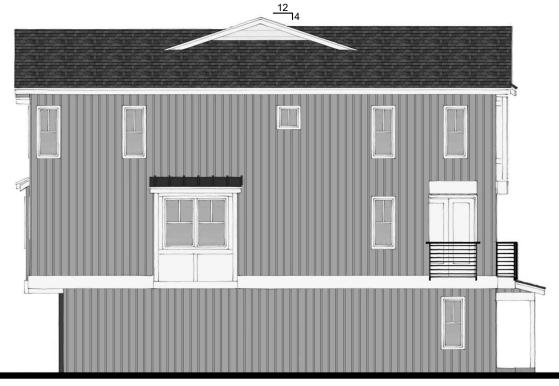






A1-0






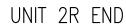



A1-1

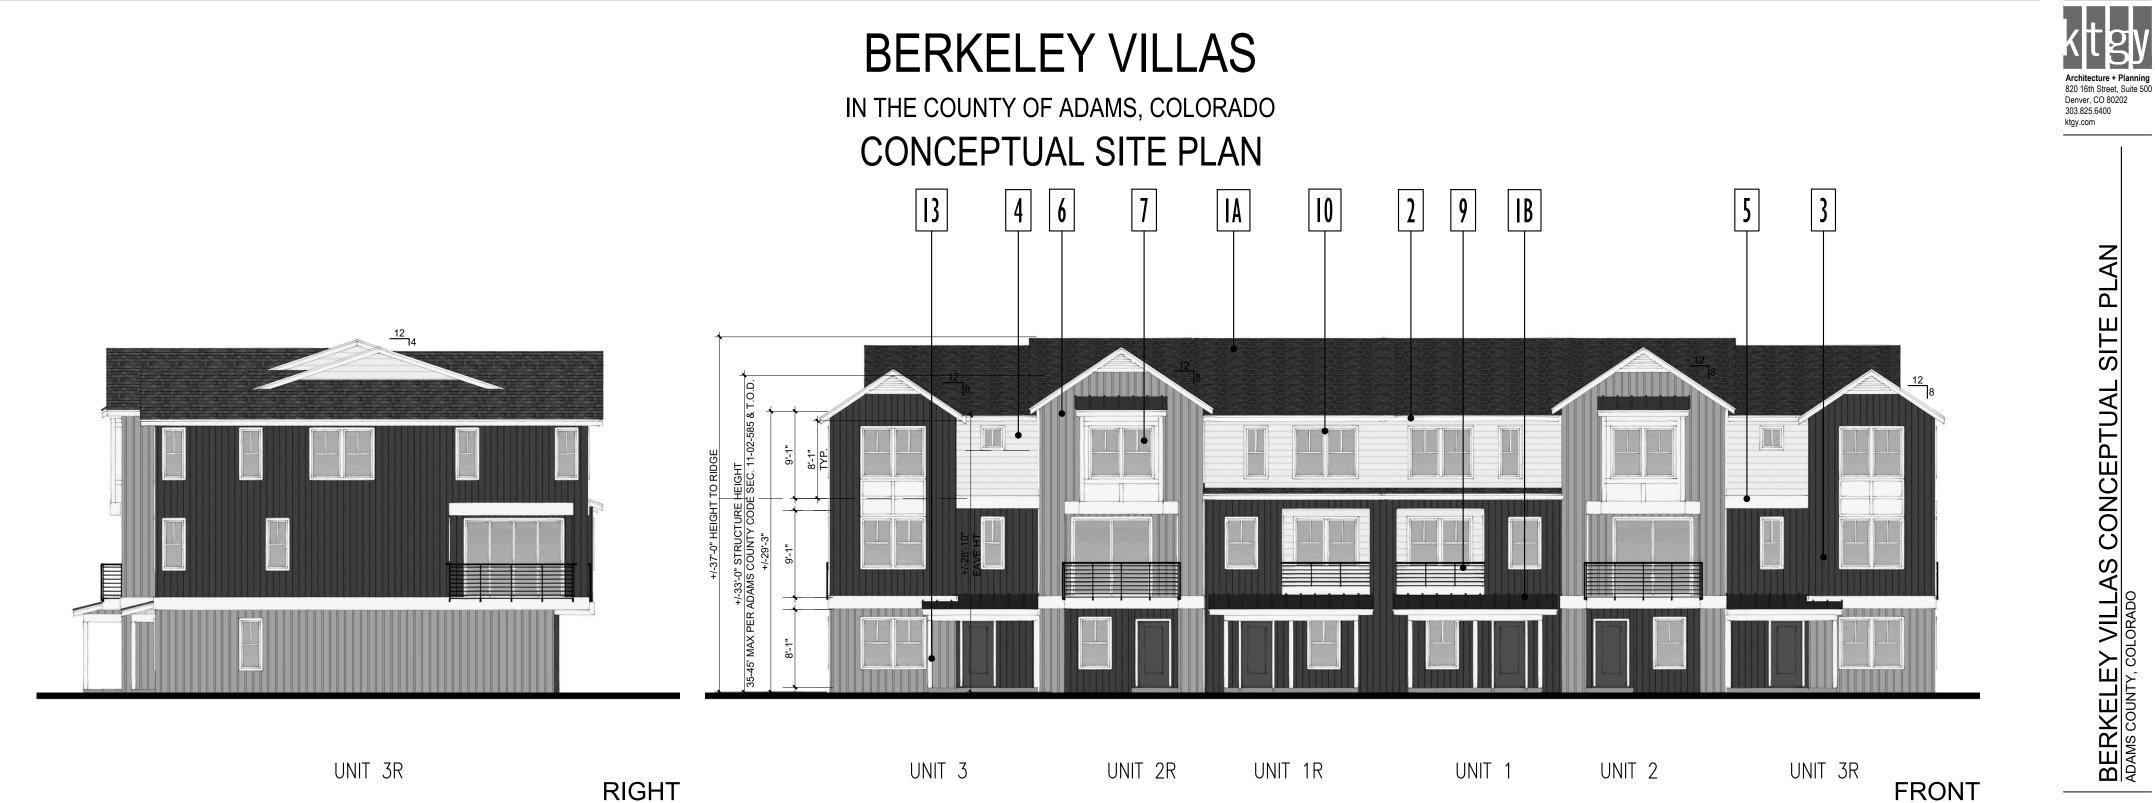





- 2 WOOD FASCIA BOARD
- 3 FIBER CEMENT VERTICAL SIDING
- 4 FIBER CEMENT LAP SIDING
- 5 WOOD OR FIBER CEMENT BOARD TRIM
- 6 FIBER CEMENT BOARD AND BATTEN
- 7 BAY WINDOW

- 9 METAL GUARDRAIL
- IO VINYL WINDOW SYSTEM
- METAL SECTIONAL GARAGE DOOR

   W/WINDOWS
- 12 DECORATIVE EXTERIOR LIGHT FIXTURE
- I WOOD PORCH POST
- [14] MASONRY VENEER WHERE SHOWN

EAVES AND RIDGES FOR GABLE, HIP, OR GAMBREL ROOFS PER ADAMS COUNTY CODE SEC. 11-02-585.

BUILDING MATERIALS, COLORS/CONTRASTING COLORS, AND WINDOW/DOOR PLACEMENTS MAY VARY AT TIME OF DESIGN ENTITLEMENT.

ADDRESS NUMBERS FOR EACH SINGLE-FAMILY ATTACHED TOWNHOME SHALL BE PLAED IN A POSITION THAT IS PLAINLY LEGIBLE AND VISIBLE FROM THE STREET OR ROAD FRONTING THE PROPERTY. THESE NUMBERS SHALL CONTRAST WITH THEIR BACKGROUND AND BE A MINIMUM 4 INCHES HIGH WITH A MINIMUM STROKE WIDTH OF 0.5 INCHES. IF NOT CLEARLY VISIBLE FROM THE STREET NUMBER SIZE MAY NEED TO BE GREATER THAN 4".

UNECTED E DRAWN BY: FILENAME:

 $\left( \right)$ 


5

10



OWNER:

TTLC MANAGEMENT, INC DAVID CLOCK 1350 17TH ST, STE 350 DENVER, CO 80202

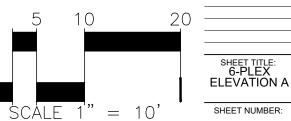

A2-0





ADDRESS NUMBERS FOR EACH SINGLE-FAMILY ATTACHED TOWNHOME SHALL BE PLAED IN A POSITION THAT IS PLAINLY LEGIBLE AND VISIBLE FROM THE STREET OR ROAD FRONTING THE PROPERTY. THESE NUMBERS SHALL CONTRAST WITH THEIR BACKGROUND AND BE A MINIMUM 4 INCHES HIGH WITH A MINIMUM STROKE WIDTH OF 0.5 INCHES. IF NOT CLEARLY VISIBLE FROM THE STREET NUMBER SIZE MAY NEED TO BE GREATER THAN 4".

- 2 WOOD FASCIA BOARD
- 3 FIBER CEMENT VERTICAL SIDING
- 4 FIBER CEMENT LAP SIDING
- 5 WOOD OR FIBER CEMENT BOARD TRIM

METAL SECTIONAL GARAGE DOOR W/WINDOWS

4 MASONRY VENEER WHERE SHOWN

13 WOOD PORCH POST

12 DECORATIVE EXTERIOR LIGHT FIXTURE

- 6 FIBER CEMENT BOARD AND BATTEN
- 7 BAY WINDOW


UTEUNEU E DRAWN BY: FILENAME:

BUILDING MATERIALS, COLORS/CONTRASTING COLORS, AND WINDOW/DOOR PLACEMENTS MAY VARY AT TIME OF DESIGN ENTITLEMENT.

()

5

10

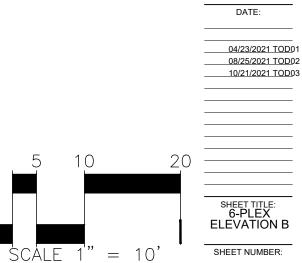

BERKELEY VILLAS CONCEPTUAL SITE PLAN ADAMS COUNTY, COLORADO

OWNER:

A2-1

SHEET NUMBER:

# LEGAL DESCRIPTION

PER LAND TITLE GUARANTEE COMPANY COMMITMENT ORDER NO ABJ70642345 WITH AN EFFECTIVE DATE OF 10/23/2019 AT 5:00 P.PM: THE SOUTH 150 FEET OF LOTS 4, 5, AND 6, LOTS 7, 8, AND 9, THE WEST 25 FEET OF THE NORTH 160 FEET OF LOT 6, THE EAST 20 FEET LOT 4 AND THE NORTH 150 FEET OF LOT 19, EXCEPT THE NORTH 160 OF LOT 7, OF THE RE-SUBDIVISION OF WESTMOORLAND, COUNTY OF ADAMS, STATE OF COLORADO.

# **BASIS OF BEARINGS**

BEARINGS SHOWN HEREON ARE GRID BEARINGS DERIVED FROM GPS OBSERVATION BASED UPON THE COLORADO COORDINATE SYSTEM OF 1983 CENTRAL ZONE (NAD 83,2011) REFERENCED TO THE NORTH LINE OF THAT NORTHEAST QUARTER OF SECTION 17, TOWNSHIP 3 SOUTH, RANGE 68 WEST, SIXTH PRINCIPAL MERIDIAN BEING MONUMENTED AS SHOWN HEREON, TAKEN TO BEAR NORTH 89°59'11" EAST, A DISTANCE OF 2,654.48 FEET.

# FLOODPLAIN

THE SURVEYED PROPERTY FALLS WITHIN ZONE X OF THE FEDERAL EMERGENCY MANAGEMENT AGENCY FLOOD INSURANCE RATE MAP NO. 08001C0592H, DATED MARCH 5, 2007, ZONE X IS DEFINED AS AREAS DETERMINED TO BE OUTSIDE THE 0,2-PERCENT ANNUAL CHANCE FLOODPLAIN.

# DRAINAGE


THE POLICY OF THE COUNTY REQUIRES THAT MAINTENANCE ACCESS SHALL BE PROVIDED TO ALL STORM DRAINAGE FACILITIES TO ASSURE CONTINUOUS OPERATIONAL CAPABILITY OF THE SYSTEM. THE PROPERTY OWNERS SHALL BE RESPONSIBLE FOR THE MAINTENANCE OF ALL DRAINAGE FACILITIES INCLUDING INLETS, PIPES, CULVERTS, CHANNELS, DITCHES, HYDRAULIC STRUCTURES, AND DETENTION BASINS LOCATED ON THEIR LAND UNLESS MODIFIED BY THE SUBDIVISION DEVELOPMENT AGREEMENT. SHOULD THE OWNER FAIL TO MAINTAIN SAID FACILITIES, THE COUNTY SHALL HAVE THE RIGHT TO ENTER SAID LAND FOR THE SOLE PURPOSE OF OPERATIONS AND MAINTENANCE. ALL SUCH MAINTENANCE COST WILL BE ASSESSED TO THE PROPERTY OWNERS.

# DEVELOPER

THE TRUE LIFE COMPANIES 1250 17TH STREET, SUITE 350 DENVER, CO 80202 720-330-9211

# **CIVIL ENGINEER**

HARRIS KOCHER SMITH 1120 LINCOLN STREET, SUITE 1000 DENVER, CO 80203 303-623-6300

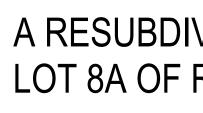

# BERKELEY VILLAS SUBDIVISION PLAT


A RESUBDIVISION OF LOTS 4, 5, 6, 7, AND 19 OF THE WESTMOORLAND SUBDIVISION PLAT AND LOT 8A OF RE-SUBDIVISION OF WESTMOORLAND PLAT CORRECTION NO. 2 BEING IN THE NE/4

OF S17, T3S, R68W OF THE 6TH PM

COUNTY OF ADAMS, STATE OF COLORADO

PRELIMINARY PLAT

SHEET 1 OF 6

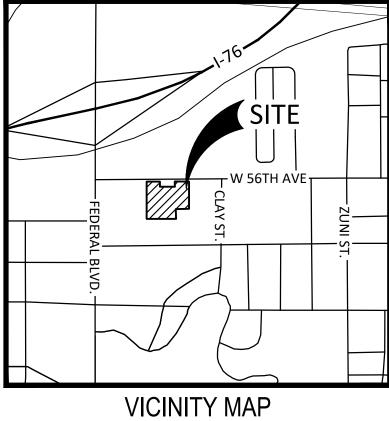

SCALE: 1" = 1000'

i					
	TRACT SUMMARY TABLE				
TRACT	PURPOSE/DESCRIPTION	TO BE OWNED	TO BE MAINTAINED	AREA (ACRE)	PAGE
А	DRAINAGE	HOA	HOA	0.12	2
В	ROADWAY, LANDSCAPE, UTILITY	HOA	HOA	1.62	2,3,4
С	LANDSCAPE	HOA	HOA	0.32	2,4
D	LANDSCAPE	HOA	HOA	0.06	4
E	LANDSCAPE	HOA	HOA	0.07	3
F	LANDSCAPE	HOA	HOA	0.04	3
G	LANDSCAPE	HOA	HOA	0.13	2,3
Н	LANDSCAPE	HOA	HOA	0.15	3,4

ISSUE D	ISSUE DATE: 08-23-2021 PROJECT #: 200810		
DATE	REVI	SION COMMENTS	

# Case Number PRC2021-0003

# **OWNER'S CERTIFICATE:**

KNOW ALL MEN BY THESE PRESENTS THAT (THE TRUE LIFE COMPANIES, BEING THE SOLE OWNER OF THE FOLLOWING DESCRIBED TRACT OF LAND:

LEGAL DESCRIPTION

HAVE BY THESE PRESENTS LAID OUT, PLATTED AND SUBDIVIDED THE SAME INTO LOTS, STREETS AND EASEMENTS AS SHOWN ON THIS PLAT UNDER THE NAME AND STYLE OF TTLC DENVER - FEDERAL BLVD.

DATE:

NAME: TITLE:

ADAMS COUNTY STATE OF COLORADO

THE FOREGOING INSTRUMENT WAS ACKNOWLEDGED BEFORE ME THIS \_\_\_\_ DAY OF \_\_\_\_\_ AD 20\_\_\_\_,

WITNESS MY HAND AND OFFICIAL SEAL MY COMMISSION EXPIRES:

NOTARY PUBLIC

ADDRESS

# SURVEYOR'S CERTIFICATION:

I, AARON MURPHY, A LICENSED LAND SURVEYOR IN THE STATE OF COLORADO, DO HEREBY CERTIFY THAT THE SURVEY FOR TTLC DENVER - FEDERAL BLVD SUBDIVISION PLAT WAS MADE UNDER MY SUPERVISION AND THE ACCOMPANYING PLAN ACCURATELY AND PROPERLY SHOWS SAID SURVEY.

AARON MURPHY, PLS 38162 FOR AND ON BEHALF OF HARRIS KOCHER SMITH

# PLANNING COMMISSION APPROVAL

APPROVED BY THE ADAMS COUNTY BOARD OF COUNTY COMMISSIONERS THIS \_\_\_\_ DAY OF \_\_\_\_\_ A.D. 2021

CHAIR

# BOARD OF COUNTY COMMISSIONERS:

APPROVED BY THE ADAMS COUNTY BOARD OF COUNTY COMMISSIONERS THIS \_\_\_\_ DAY OF \_\_\_\_\_ A.D. 2021

CHAIR

# **CLERK & RECORDER'S CERTIFICATION:**

}SS.

STATE OF COLORADO

COUNTY OF ADAMS

I HEREBY, CERTIFY THAT THIS INSTRUMENT WAS FILED FOR RECORD IN MY OFFICE AT \_\_\_\_\_O'CLOCK \_\_\_.M., \_\_\_\_\_20 \_\_\_, AND DULY RECORDED UNDER RECEPTION #\_\_\_\_\_

CLERK AND RECORDER; EX-OFFICIO CLERK OF THE COUNTY OF ADAMS

BY\_\_\_\_\_DEPUTY

# FEE\_\_\_\_\_

# **DEDICATION STATEMENTS:**

THE UNDERSIGNED DOES HEREBY DEDICATE, GRANT AND CONVEY TO ADAMS COUNTY THOSE PUBLIC EASEMENTS (AND TRACTS) AS SHOWN ON THE PLAT; AND FURTHER RESTRICTS THE USE OF ALL PUBLIC EASEMENT TO ADAMS COUNTY AND/OR ITS ASSIGNS, PROVIDED HOWEVER, THAT THE SOLE RIGHT AND AUTHORITY TO RELEASE OR QUITCLAIM ALL OR ANY SUCH PUBLIC EASEMENTS SHALL REMAIN EXCLUSIVELY VESTED IN ADAMS COUNTY.

ALL PRIVATE STREETS (ROADS A, B & C) ARE PRIVATELY OWNED AND MAINTAINED BY TTLC DENVER - FEDERAL BLVD..

# STATEMENT RESTRICTING ACCESS:

PUBLIC ACCESS ACROSS RIGHT-OF-WAY LINES, INCLUDING 56TH AVENUE, IS RESTRICTED.


# STORM DRAINAGE FACILITIES STATEMENT:

THE POLICY OF THE COUNTY REQUIRES THAT MAINTENANCE ACCESS SHALL BE PROVIDED TO ALL STORM DRAINAGE FACALITIES TO ASSURE CONTINIOUS OPERATIONAL CAPABILITY OF THE SYSTEM. THE PROPERTY OWNERS SHALL BE RESPONSIBLE FOR THE MAINTANENCE OF ALL DRAINAGE FACILITIES INCLUDING INLETS, PIPES, CULVERTS, CHANNELS, DITCHES, HYDRAULIC STRUCTURES, AND DETENTION BASINS LOCATED ON THEIR LAND UNLESS MODIFIED BY THE SUBDIVISIOIN DEVELOPMENT AGREEMENT. SHOULD THE OWNER FAIL TO MAINTAIN SAID FACILITIES, THE COUNTY SHALL HAVE THE RIGHT TO ENTER SAID LAND FOR THE SOLE PURPOSE OF OPERATIONS AND MAINTENANCE. ALL SUCH MAINTENANCE COST WILL BE ASSESSED TO THE PROPERTY OWNERS.


**REVISION DATE:** 


ISSUE DATE: 08-23-2021

SHEET 1 OF 6

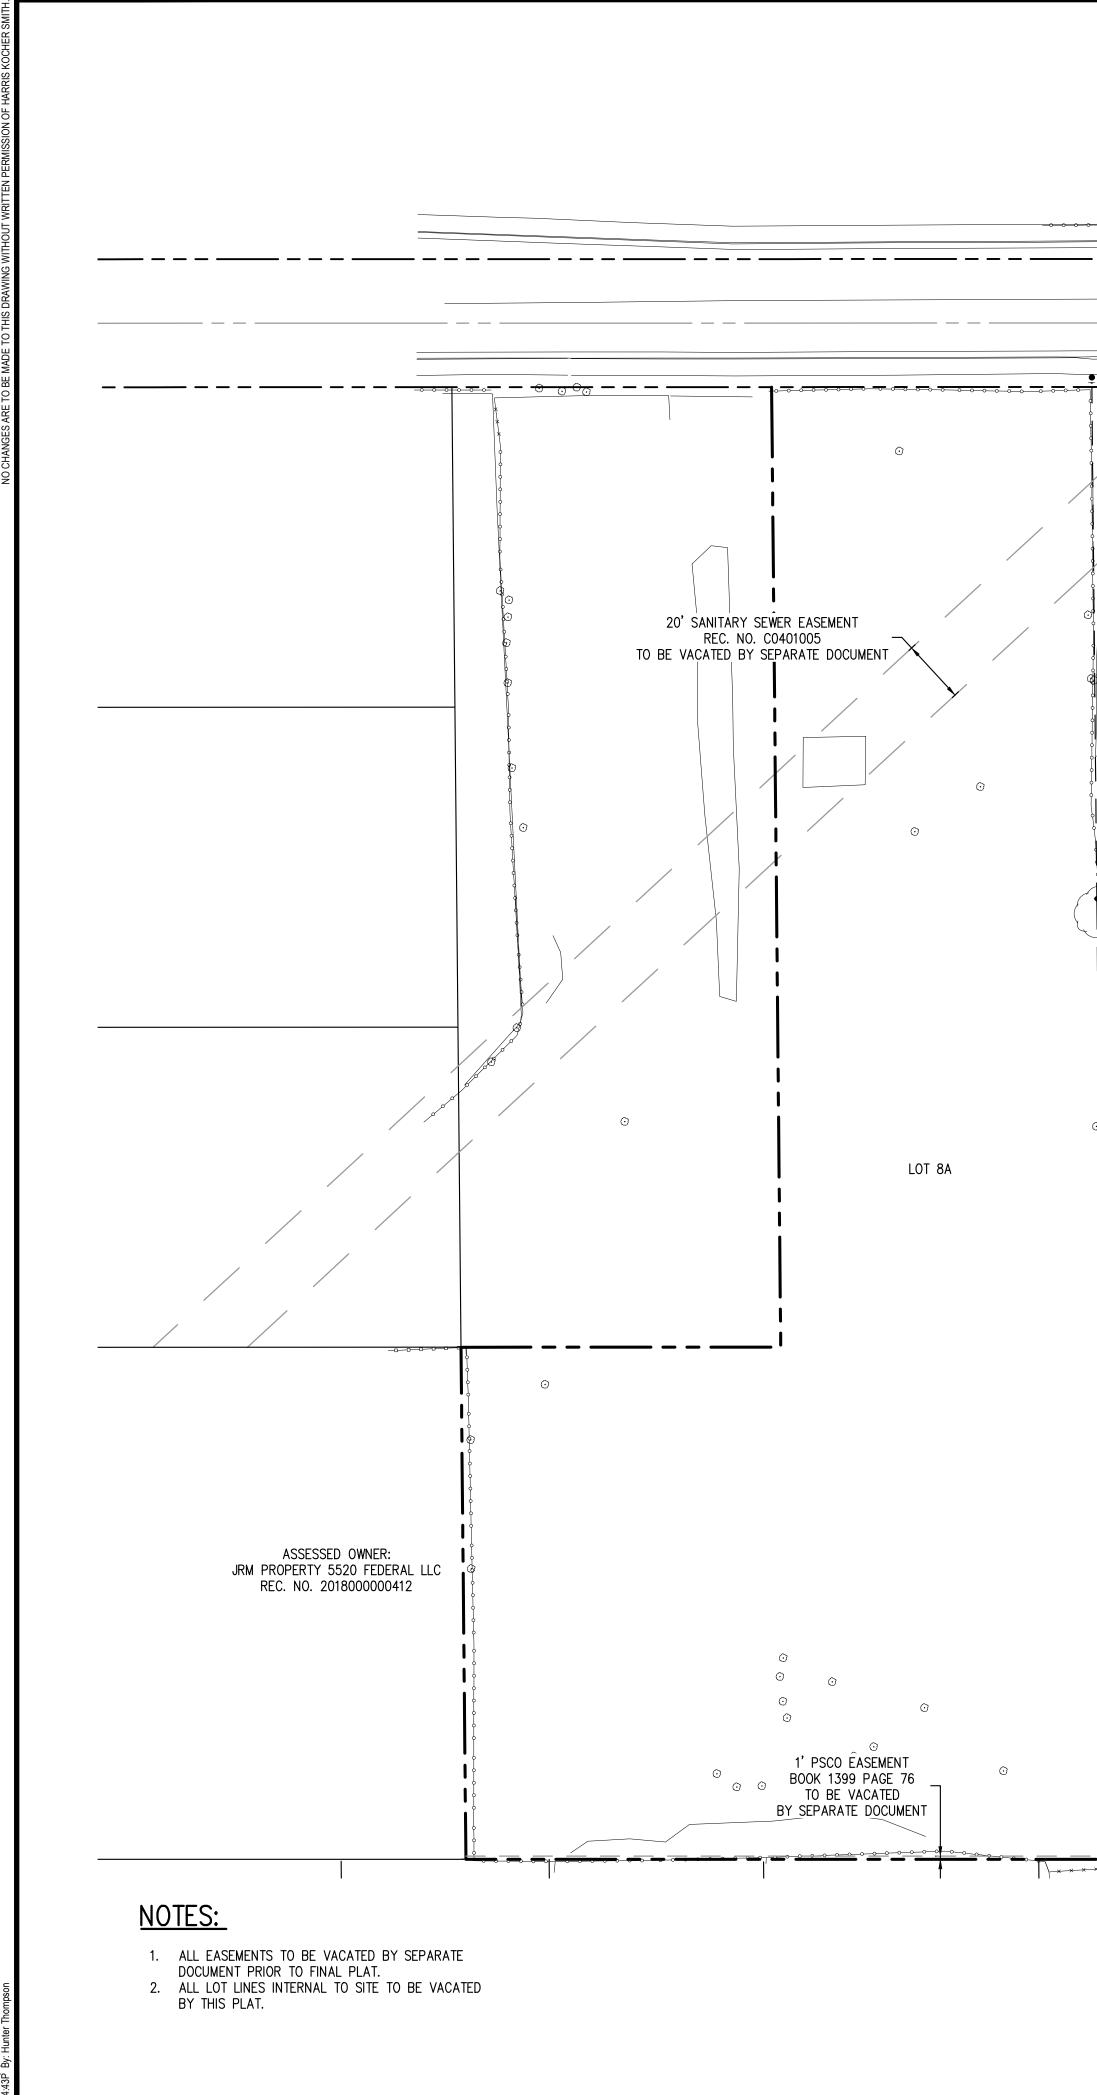


h: K:\200810\ENGINEERING\PRELIMINARY PLAT\PRELIMINARY PLAT - EXISTING CONDITIONS.DWG Layout: LAY\ Fs: e-base, e-legal, e-util[U]

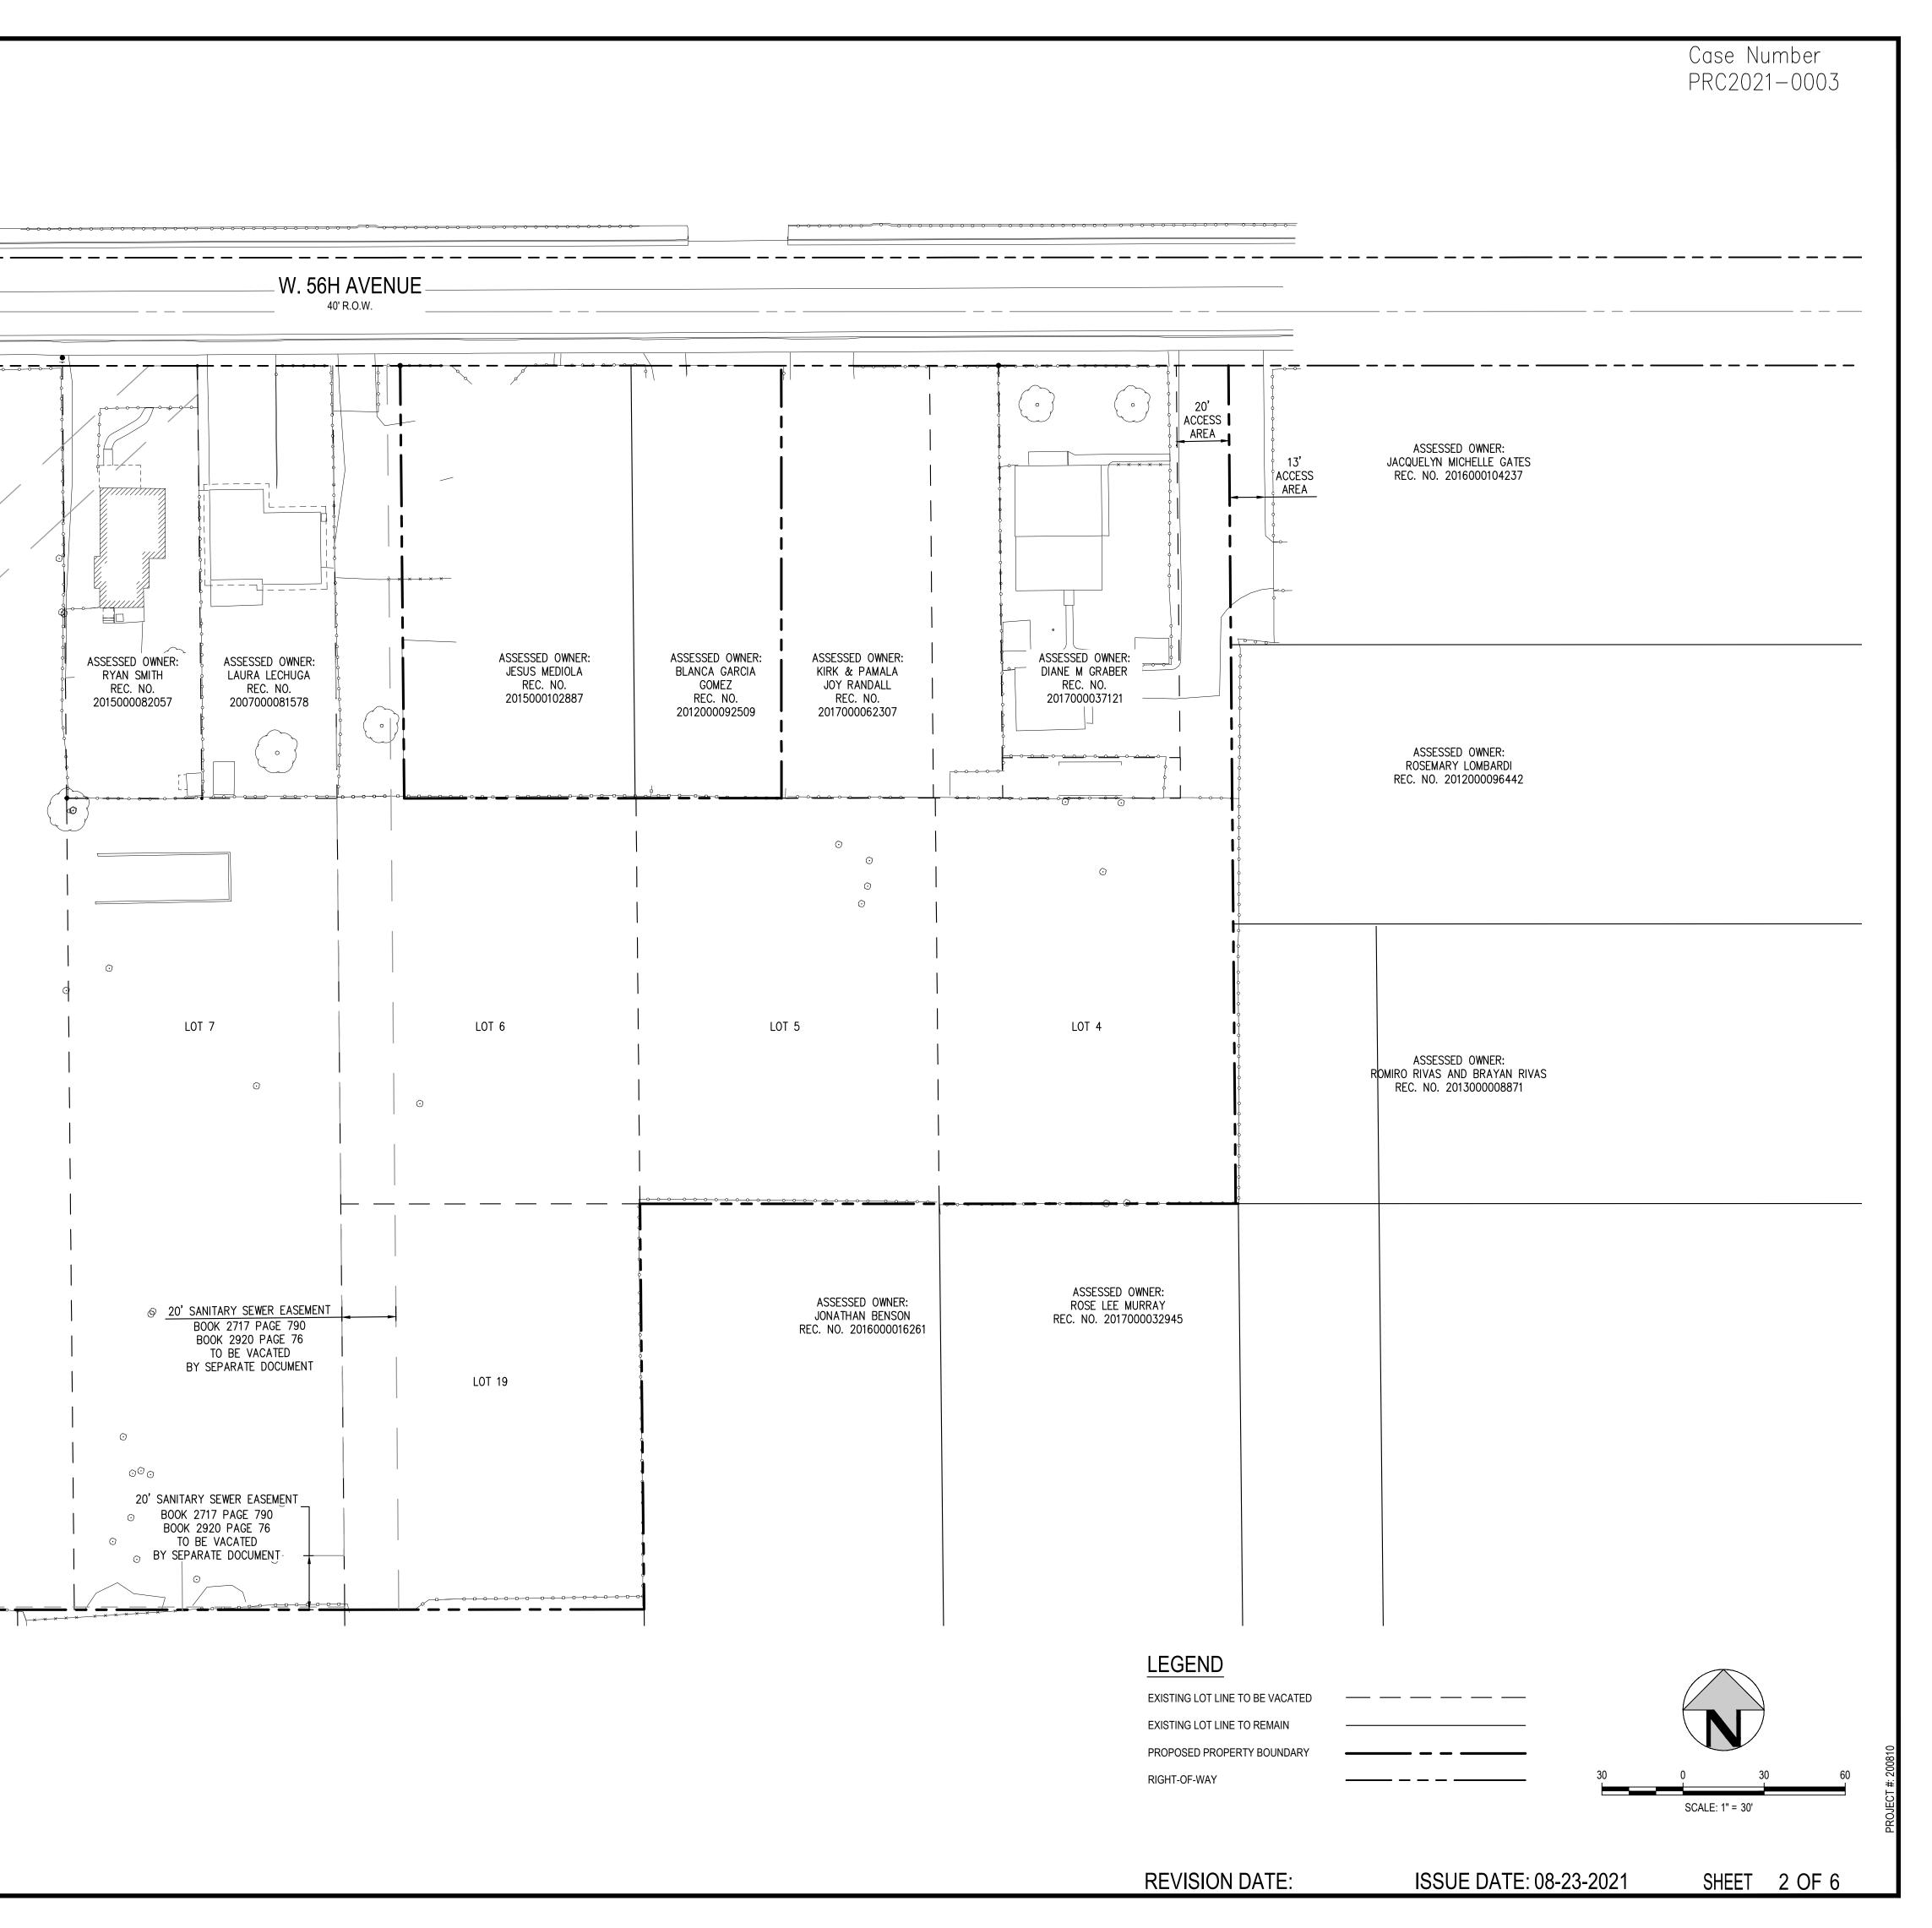

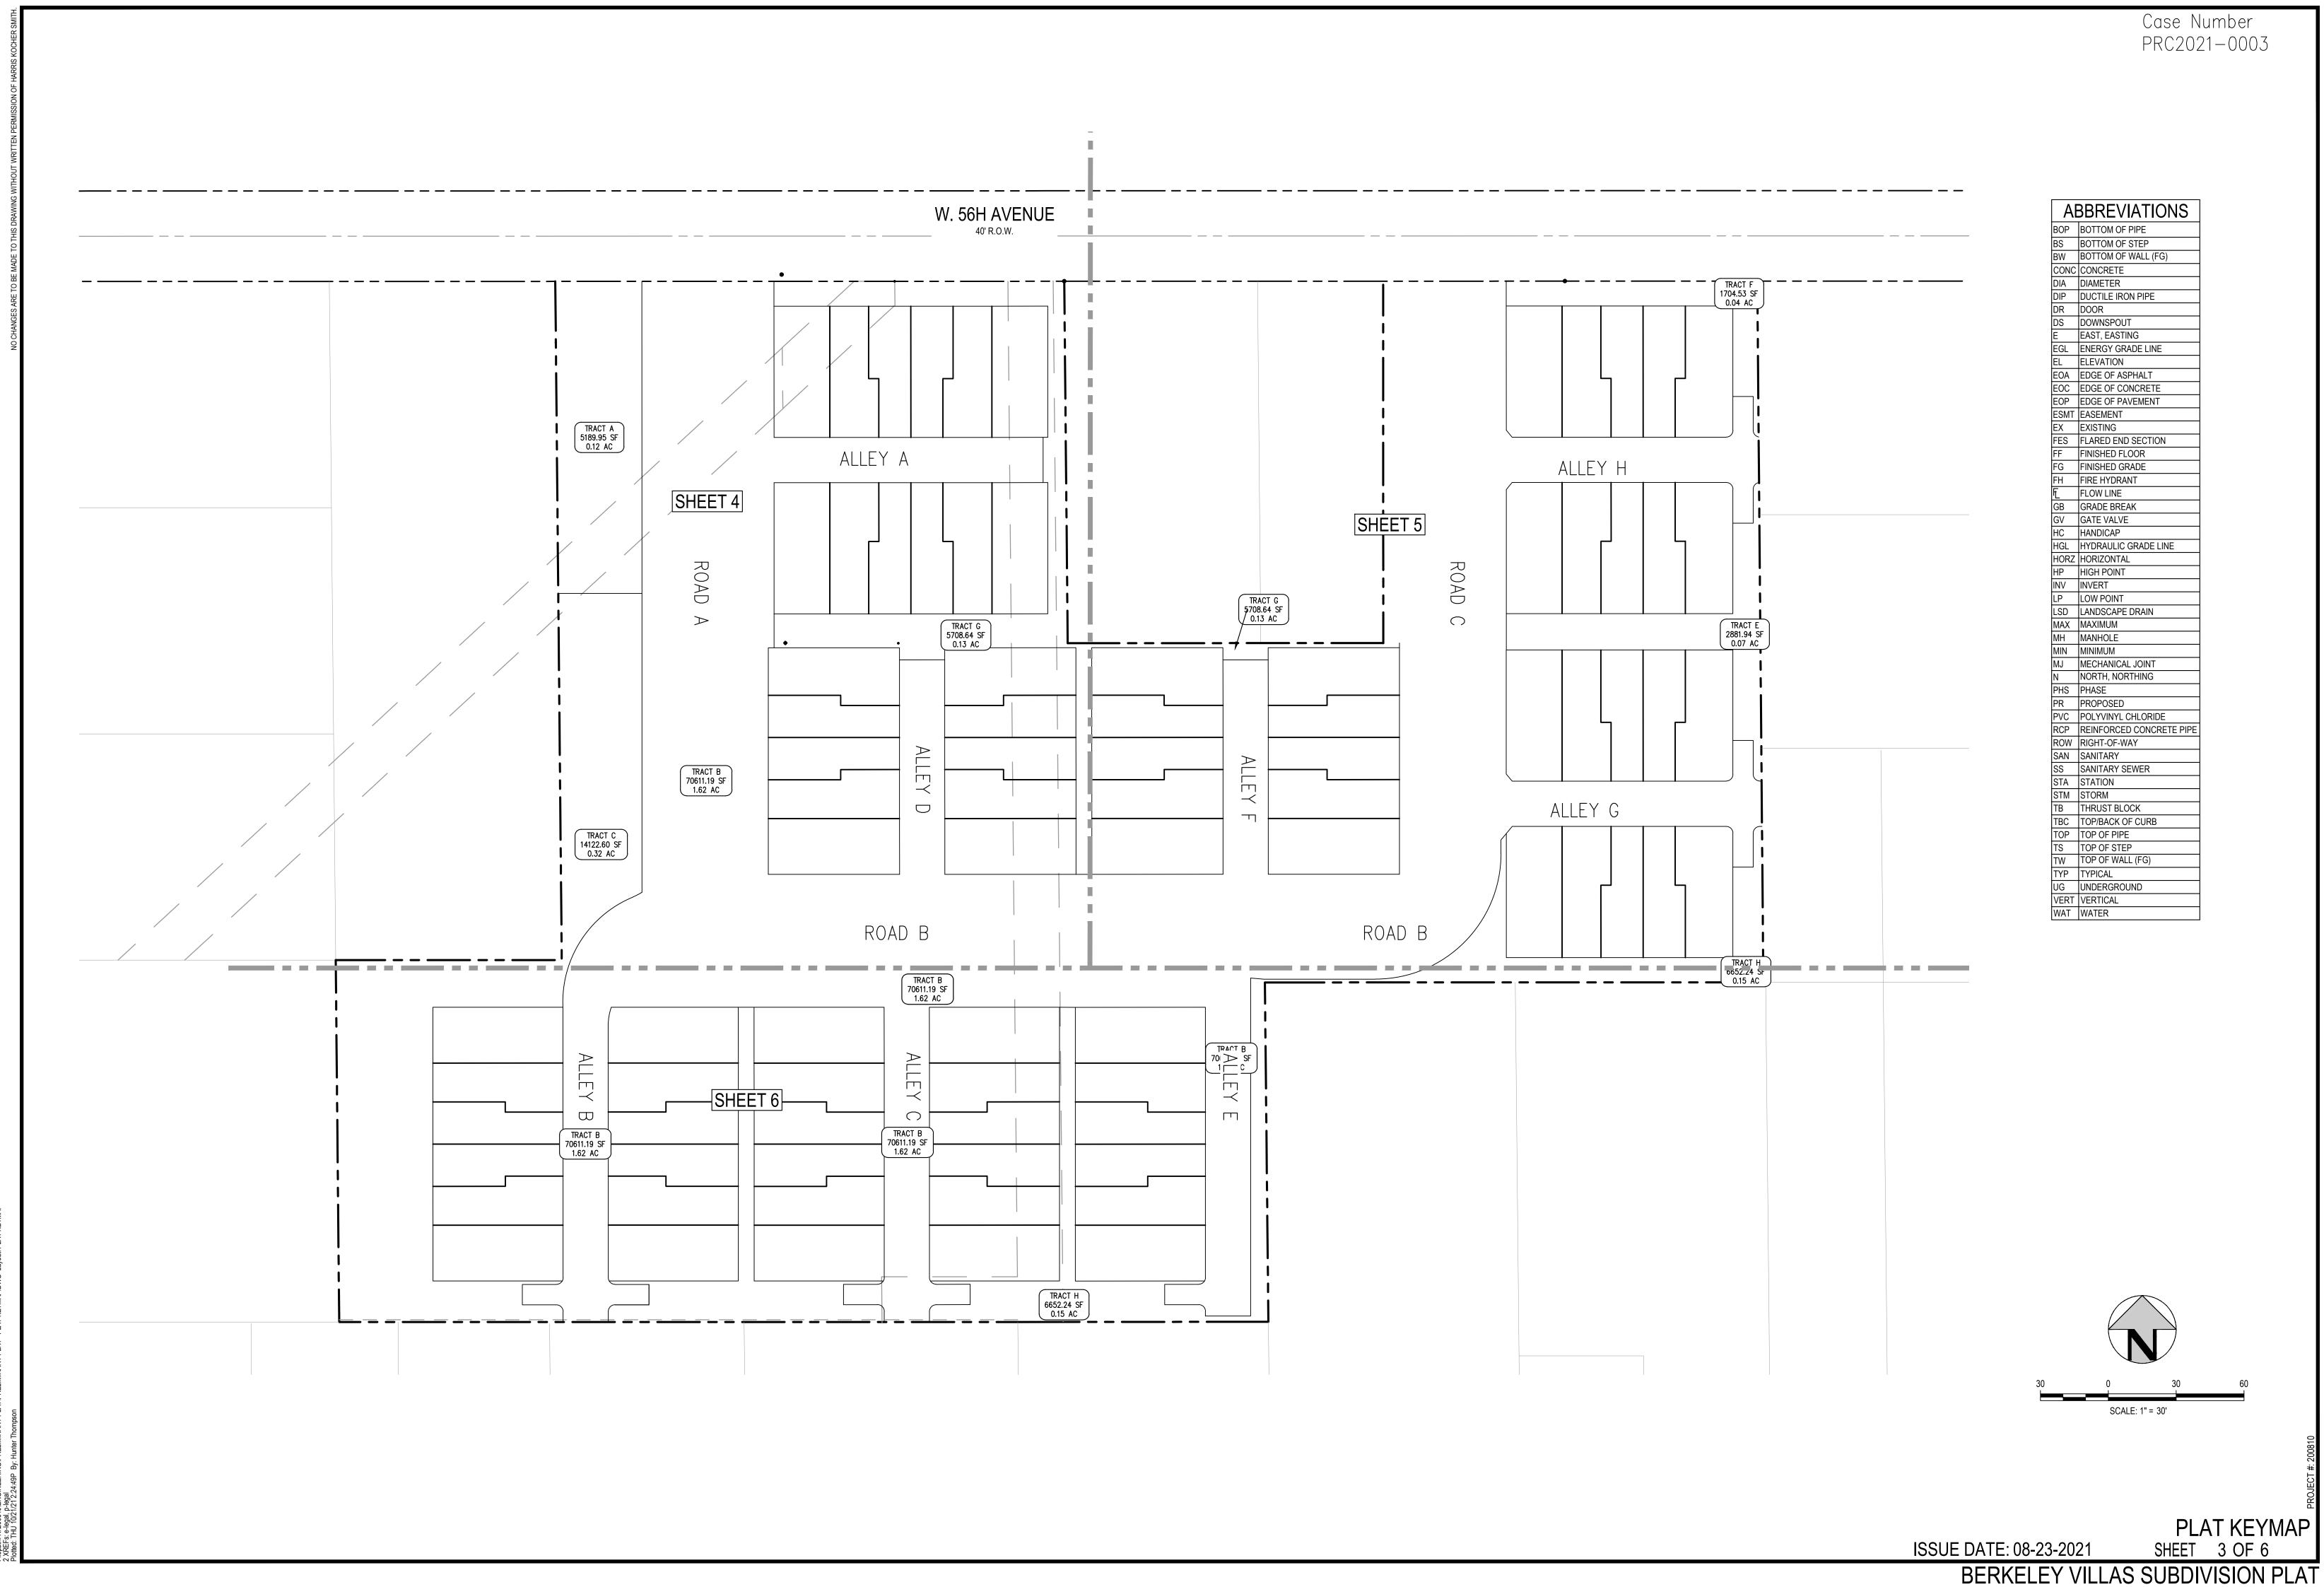

Layout: WEST	•
- SITE PLAN.DWG	
<b>ELIMINARY PLANS</b>	
LIMINARY PLAT/PR	
th: K:200810/ENGINEERING/PRELIMINARY PLAT/PRELIMINARY PLANS - SITE PLAN.DWG Layout: WEST	Eera lacal kauman[11] n-lacal
th: K:\200810	Ee. o. long b

ASSESSED OWNER: 56TH & FEDERAL LLC REC. NO. CO413982	
ASSESSED OWNER: 56TH & FEDERAL LLC REC. NO. CO413982 S6TH & FEDERAL LLC REC. NO. CO413982	
ASSESSED OWNER: 56TH & FEDERAL LLC REC. NO. CO413982	

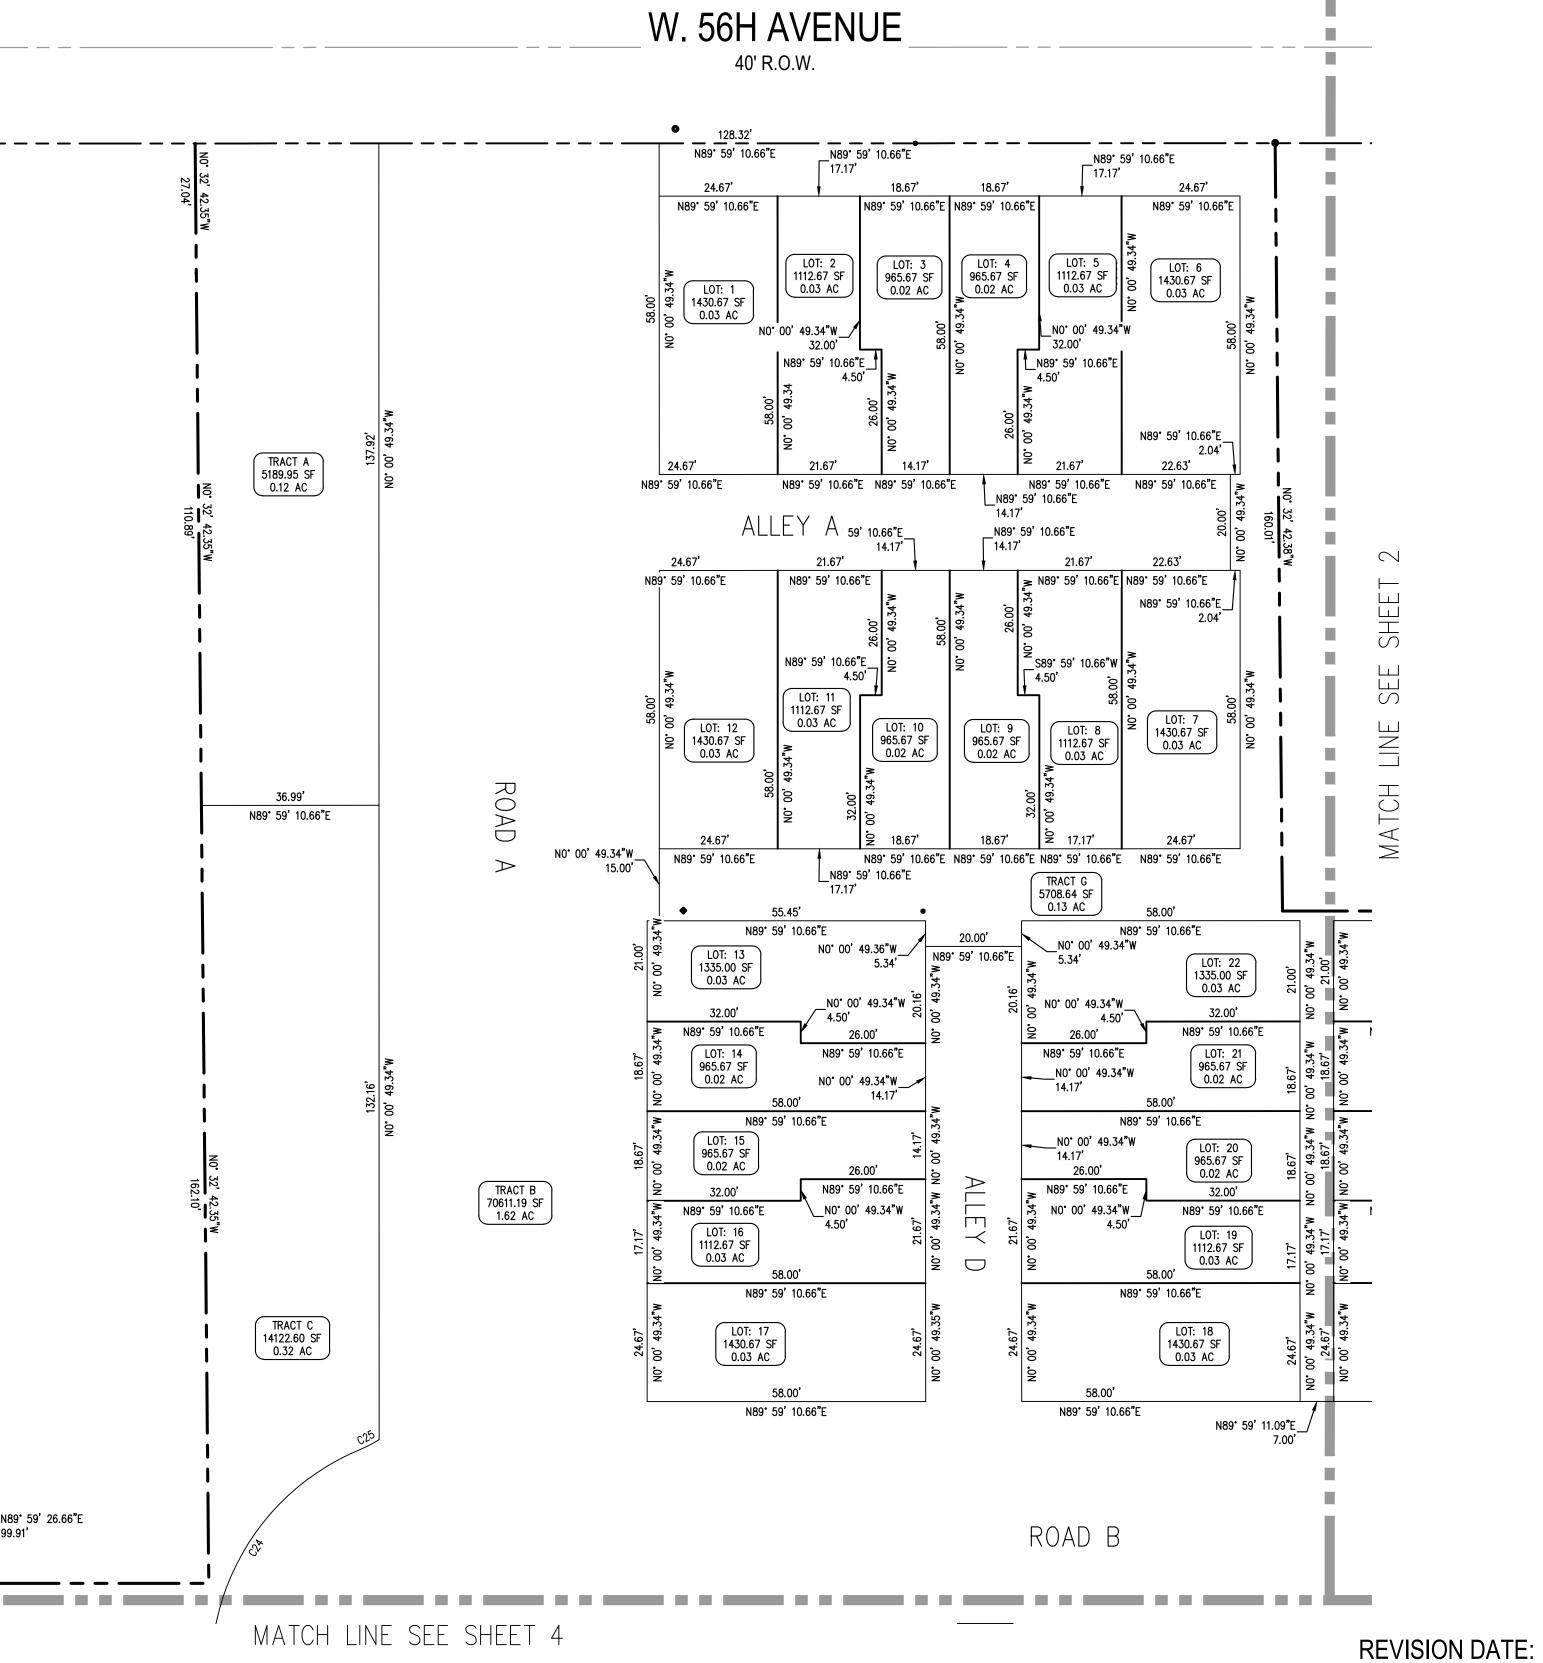


# Case Number PRC2021-0003

# LEGEND:

PROPERTY BOUNDARY RIGHT-OF-WAY LOT LINE

# <u>NOTE:</u>

THESE EASEMENTS ARE DEDICATED TO ADAMS COUNTY FOR THE BENEFIT OF THE APPLICABLE UTILITY PROVIDERS FOR THE INSTALLATION, MAINTENANCE, AND REPLACEMENT OF ELECTRIC, GAS, TELEVISION, CABLE, AND TELECOMMUNICATIONS FACILITIES (DRY UTILITIES). UTILITY EASEMENTS SHALL ALSO BE GRANTED WITHIN ANY ACCESS EASEMENTS AND PRIVATE STREETS IN THE SUBDIVISION. PERMANENT STRUCTURES, IMPROVEMENTS, OBJECTS, BUILDINGS, WELLS, AND OTHER OBJECTS THAT MAY INTERFERE WITH THE UTILITY FACILITIES OR USE THEREOF (INTERFERING OBJECTS) SHALL NOT BE PERMITTED WITHIN SAID UTILITY EASEMENTS AND THE UTILITY PROVIDERS, AS GRANTEES, MAY REMOVE ANY INTERFERIN OBJECTS AT NO COST TO SUCH GRANTEES, INCLUDING, WITHOUT LIMITATION, VEGETATION. PUBLIC SERVICE COMPANY OF COLORADO (PSCO) AND ITS SUCCESSORS RESERVE THE RIGHT TO REQUIRE ADDITIONAL EASEMENTS AND TO REQUIRE THE PROPERTY OWNER TO GRANT PSCO AN EASEMENT ON ITS STANDARD FORM.

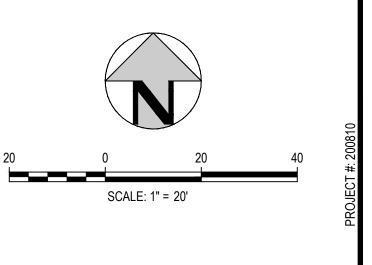


 $\sim$ SHE Ц С 

ISSUE DATE: 08-23-2021

SHEET 4 OF 6



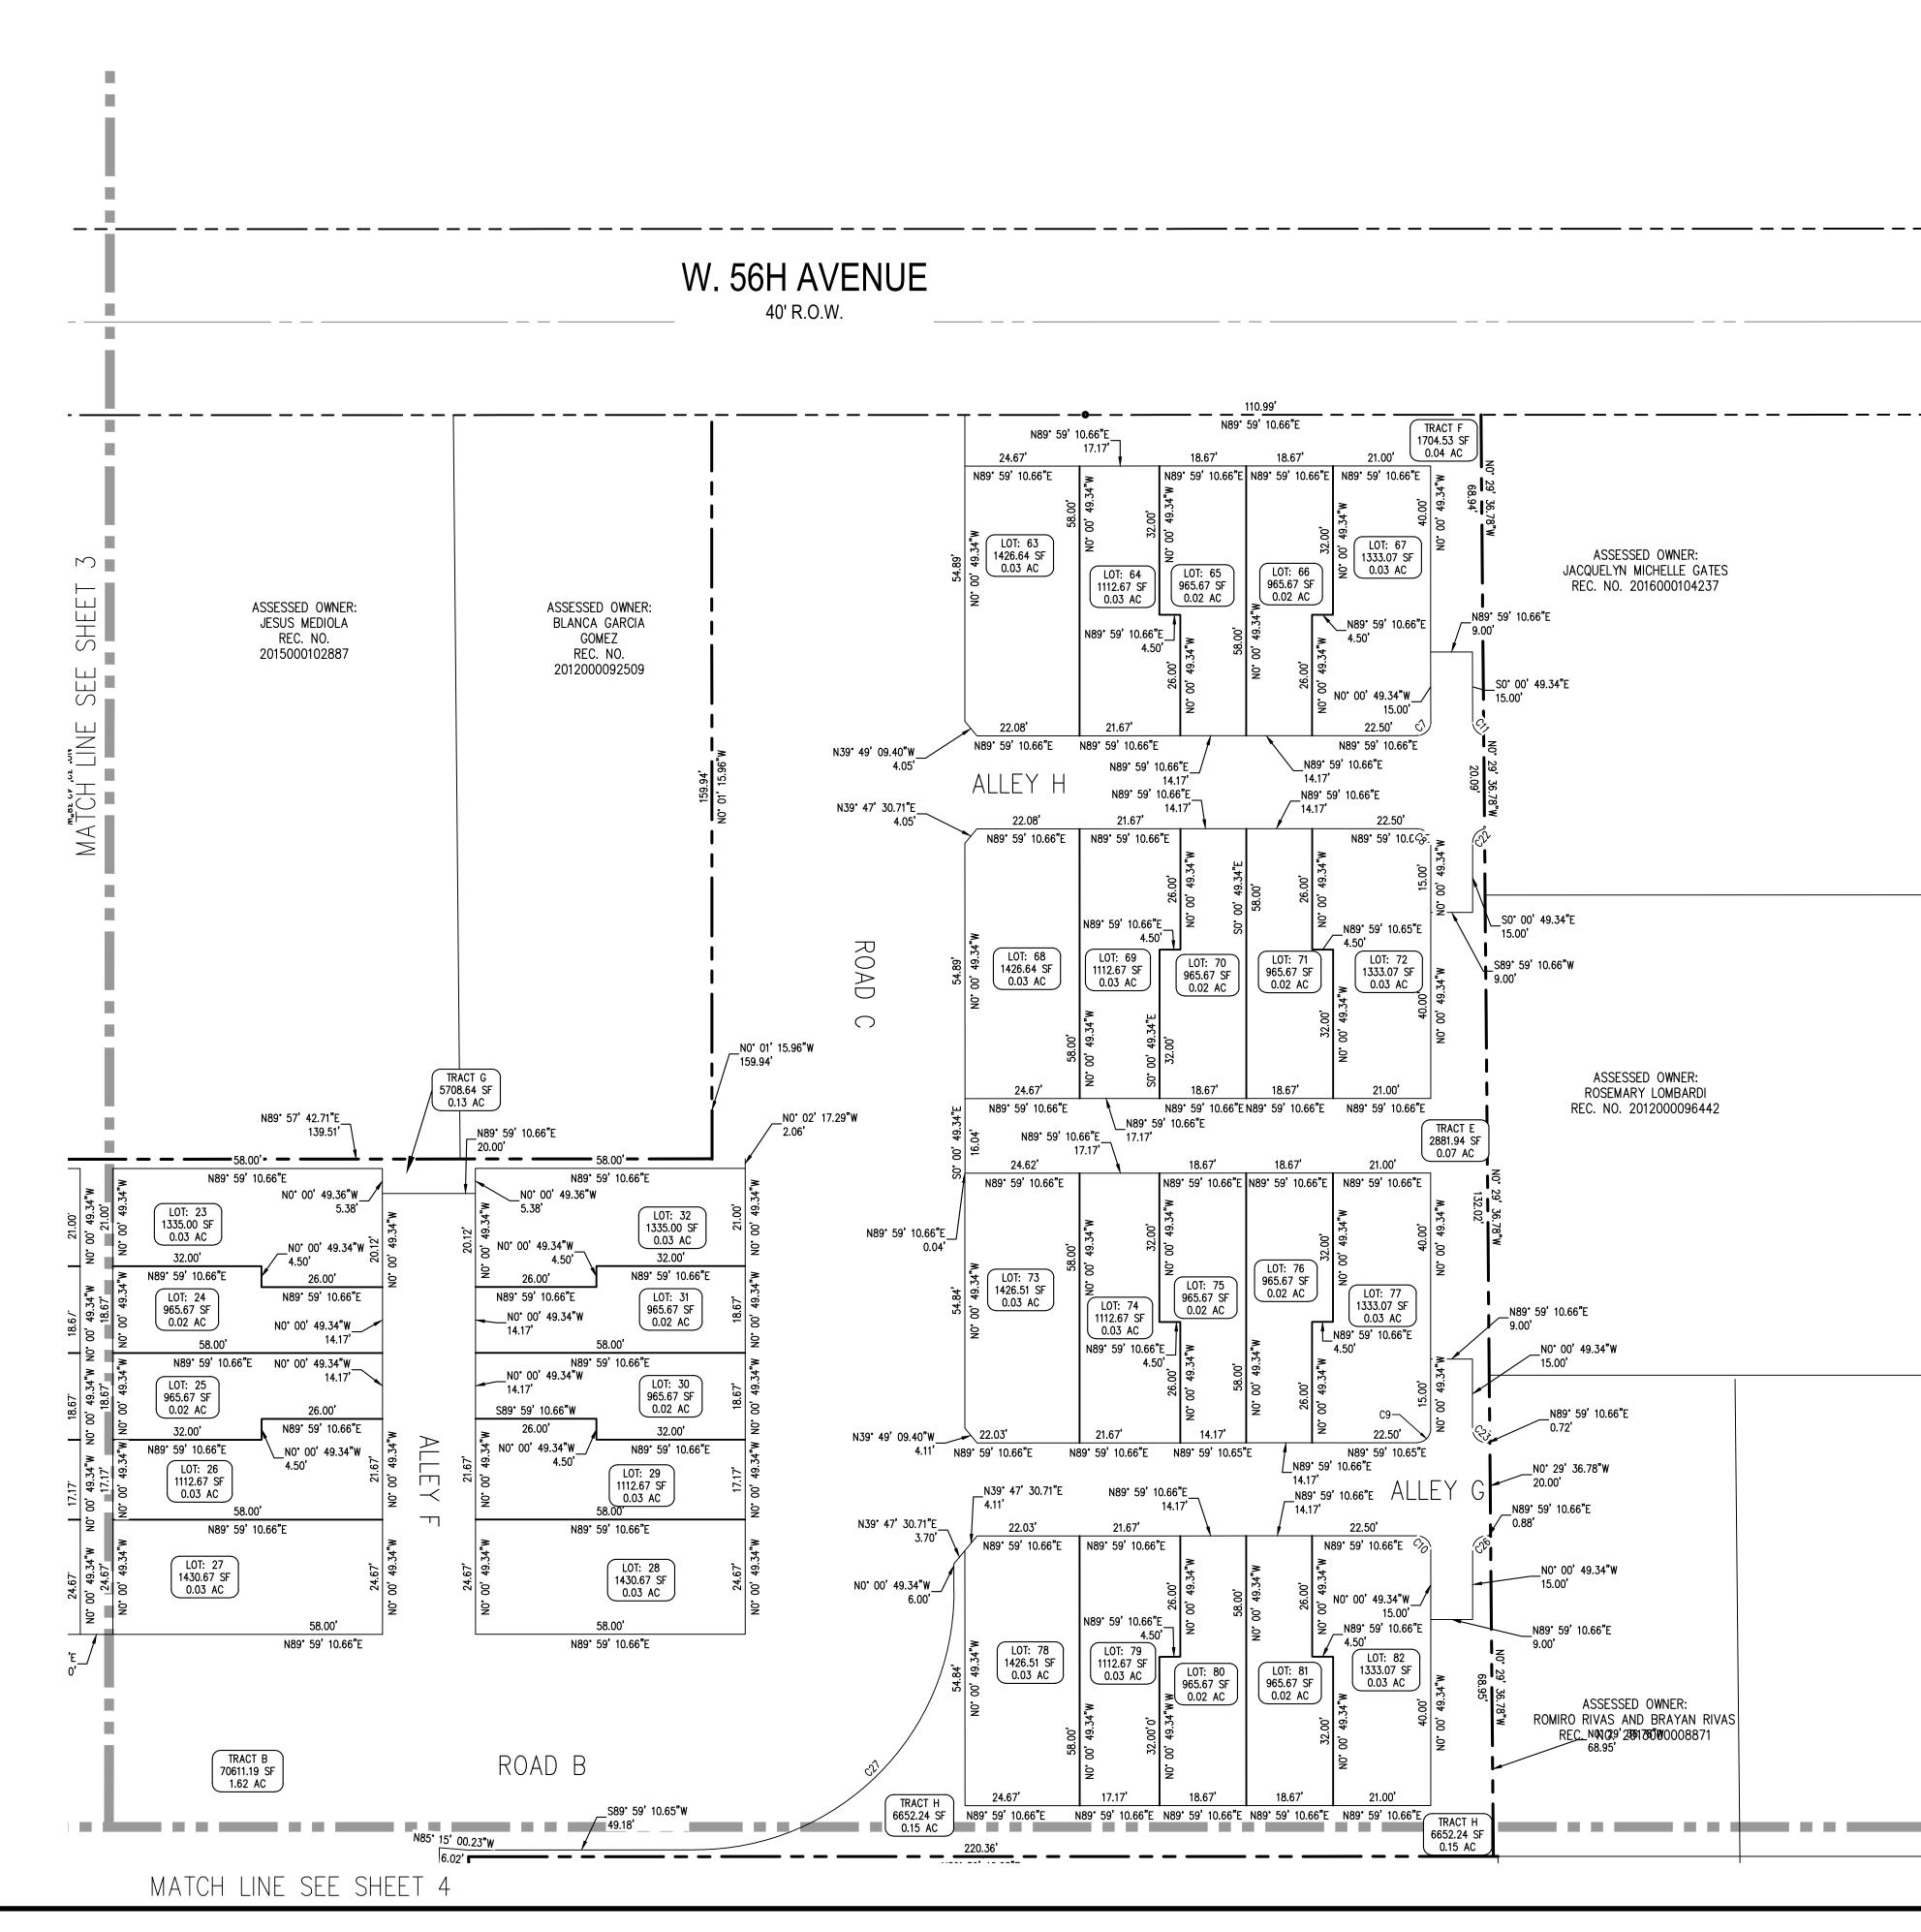


# Case Number PRC2021-0003

# LEGEND:

PROPERTY BOUNDARY RIGHT-OF-WAY LOT LINE

# <u>NOTE:</u>

THESE EASEMENTS ARE DEDICATED TO ADAMS COUNTY FOR THE BENEFIT OF THE APPLICABLE UTILITY PROVIDERS FOR THE INSTALLATION, MAINTENANCE, AND REPLACEMENT OF ELECTRIC GAS, TELEVISION, CABLE, AND TELECOMMUNICATIONS FACILITIES (DRY UTILITIES). UTILITY EASEMENTS SHALL ALSO BE GRANTED WITHIN ANY ACCESS EASEMENTS AND PRIVATE STREETS IN THE SUBDIVISION. PERMANENT STRUCTURES, IMPROVEMENTS, OBJECTS, BUILDINGS, WELLS, AND OTHER OBJECTS THAT MAY INTERFERE WITH THE UTILITY FACILITIES OR USE THEREOF (INTERFERING OBJECTS) SHALL NOT BE PERMITTED WITHIN SAID UTILITY EASEMENTS AND THE UTILITY PROVIDERS, AS GRANTEES, MAY REMOVE ANY INTERFERIN OBJECTS AT NO COST TO SUCH GRANTEES, INCLUDING, WITHOUT LIMITATION, VEGETATION. PUBLIC SERVICE COMPANY OF COLORADO (PSCO) AND ITS SUCCESSORS RESERVE THE RIGHT TO REQUIRE ADDITIONAL EASEMENTS AND TO REQUIRE THE PROPERTY OWNER TO GRANT PSCO AN EASEMENT ON ITS STANDARD FORM.

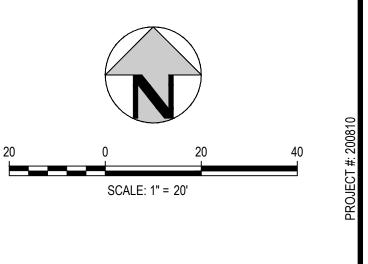


ISSUE DATE: 08-23-2021

SHEET 5 OF 6





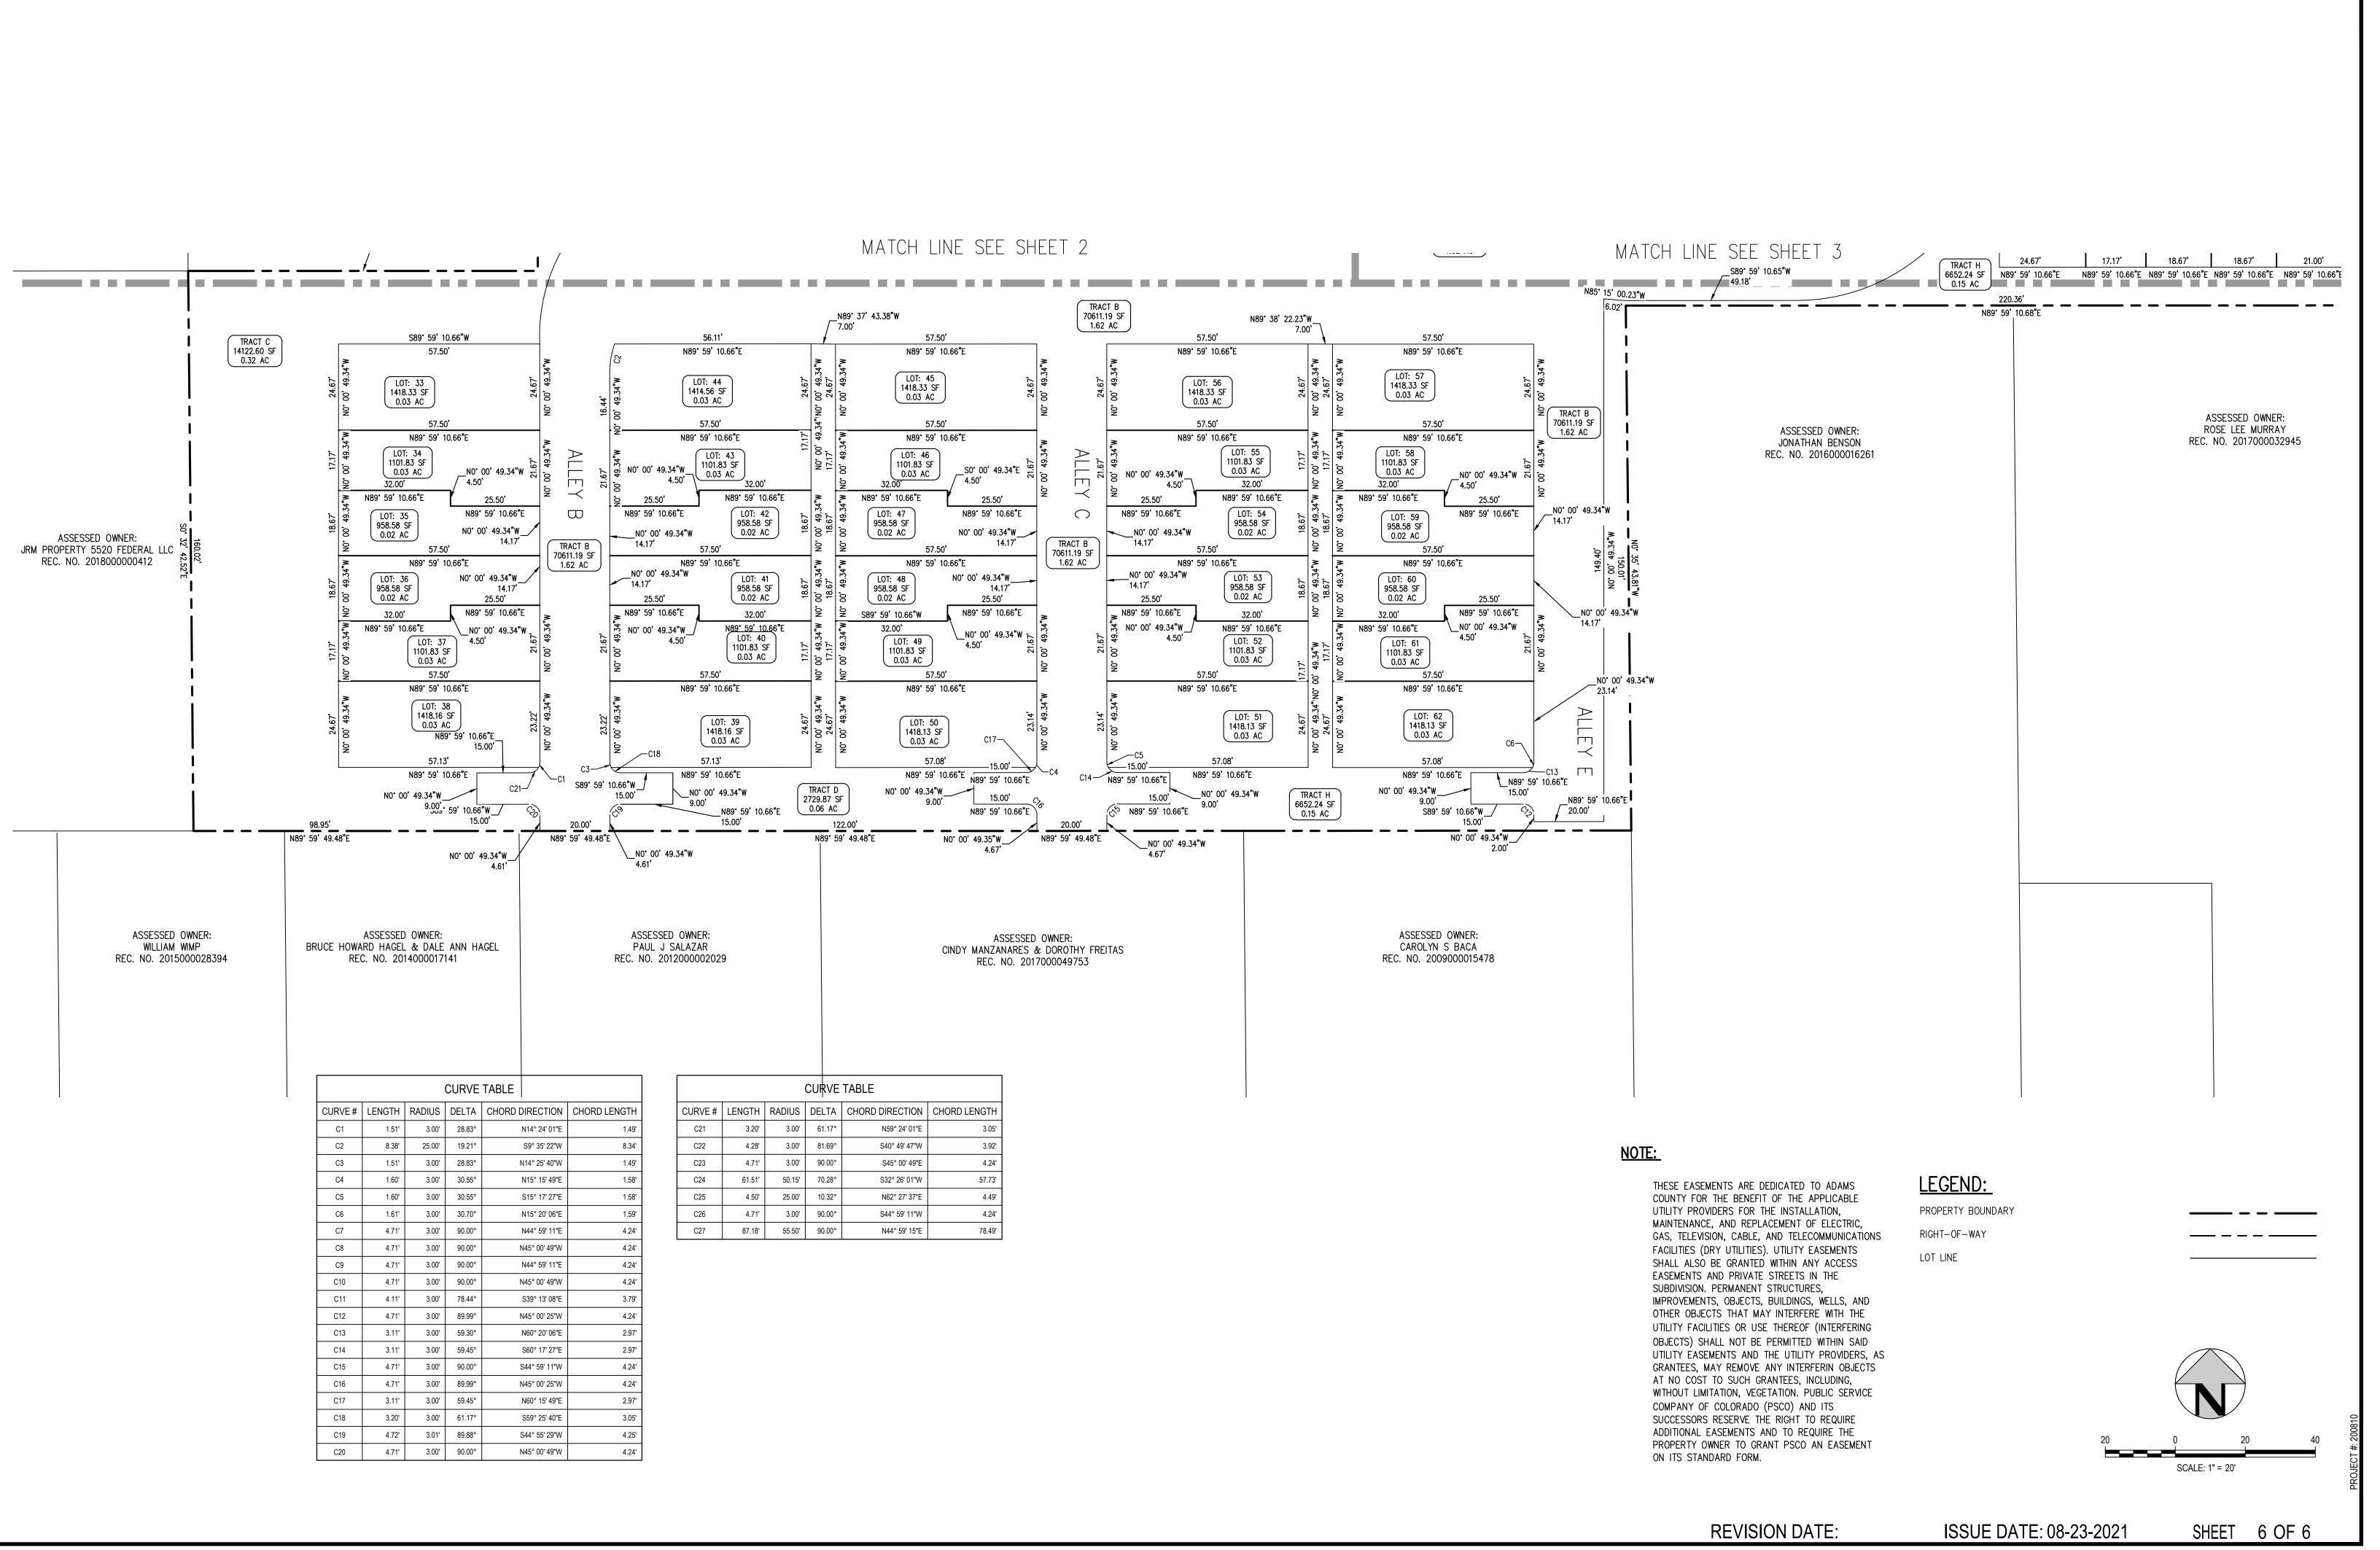

ΤH	RADIUS	DELTA	CHORD DIRECTION	CHORD LENGTH
8.20'	3.00'	61.17°	N59° 24' 01"E	3.05'
.28'	3.00'	81.69°	S40° 49' 47"W	3.92'
.71'	3.00'	90.00°	S45° 00' 49"E	4.24'
.51'	50.15'	70.28°	S32° 26' 01"W	57.73'
.50'	25.00'	10.32°	N62° 27' 37"E	4.49'
.71'	3.00'	90.00°	S44° 59' 11"W	4.24'
'.18'	55.50'	90.00°	N44° 59' 15"E	78.49'

Case Number

PRC2021-0003